
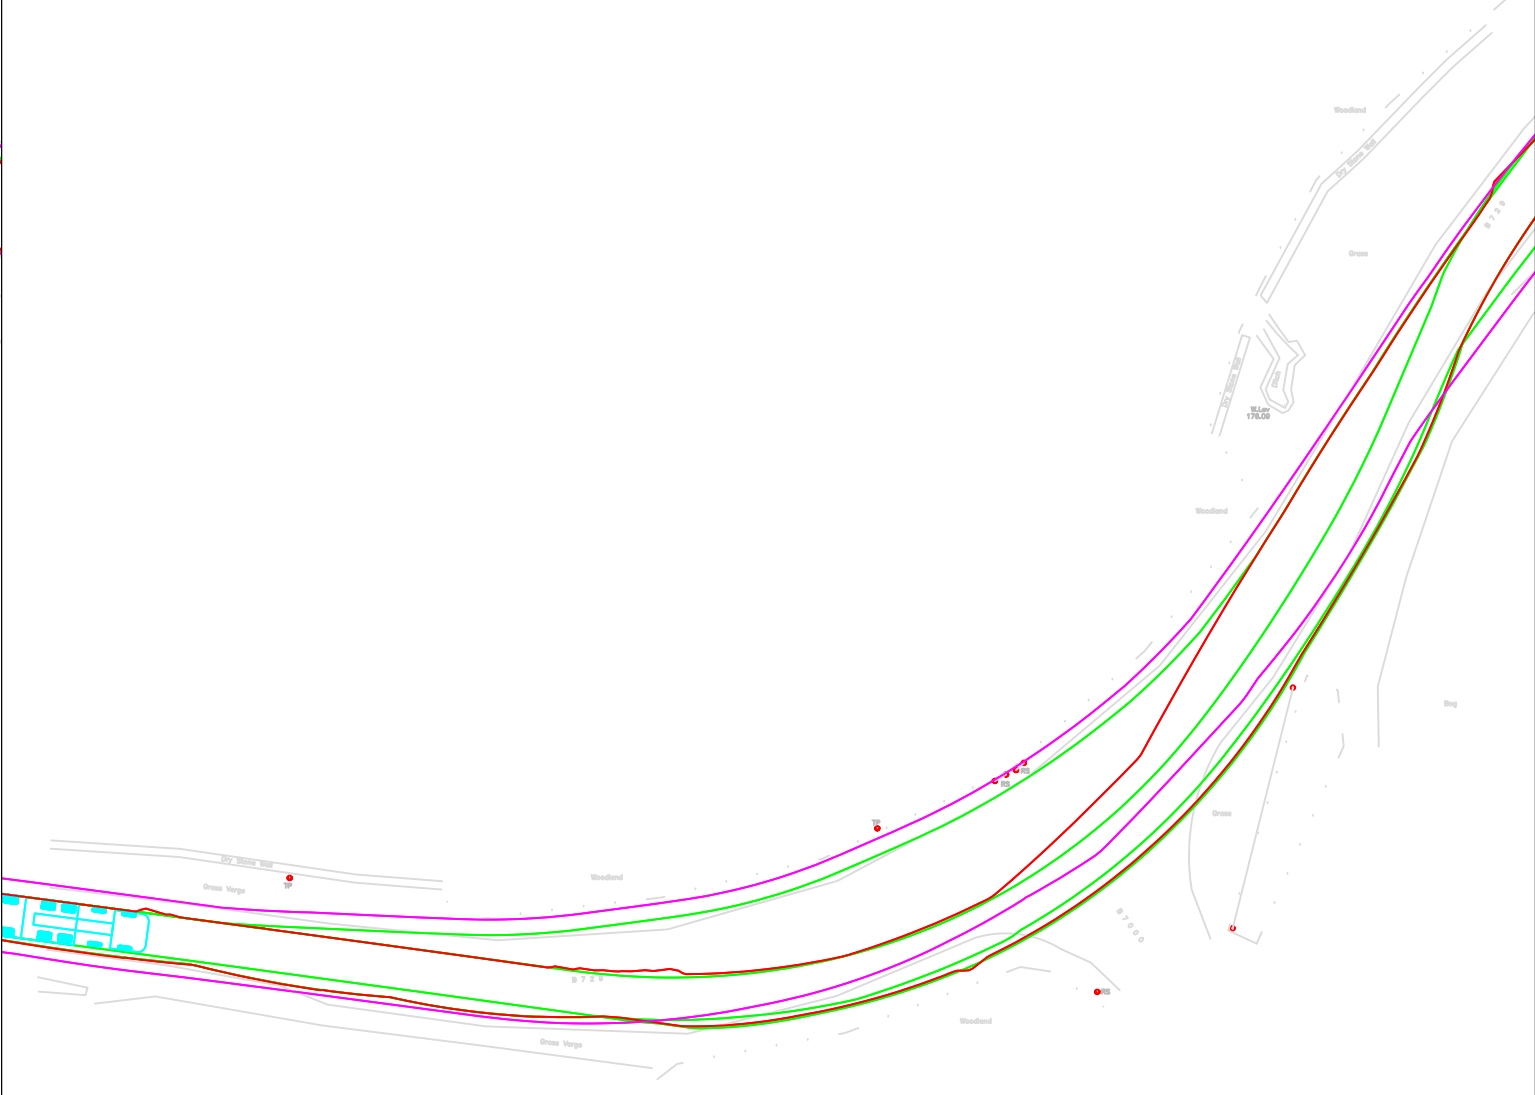



N163 Blade

Tower

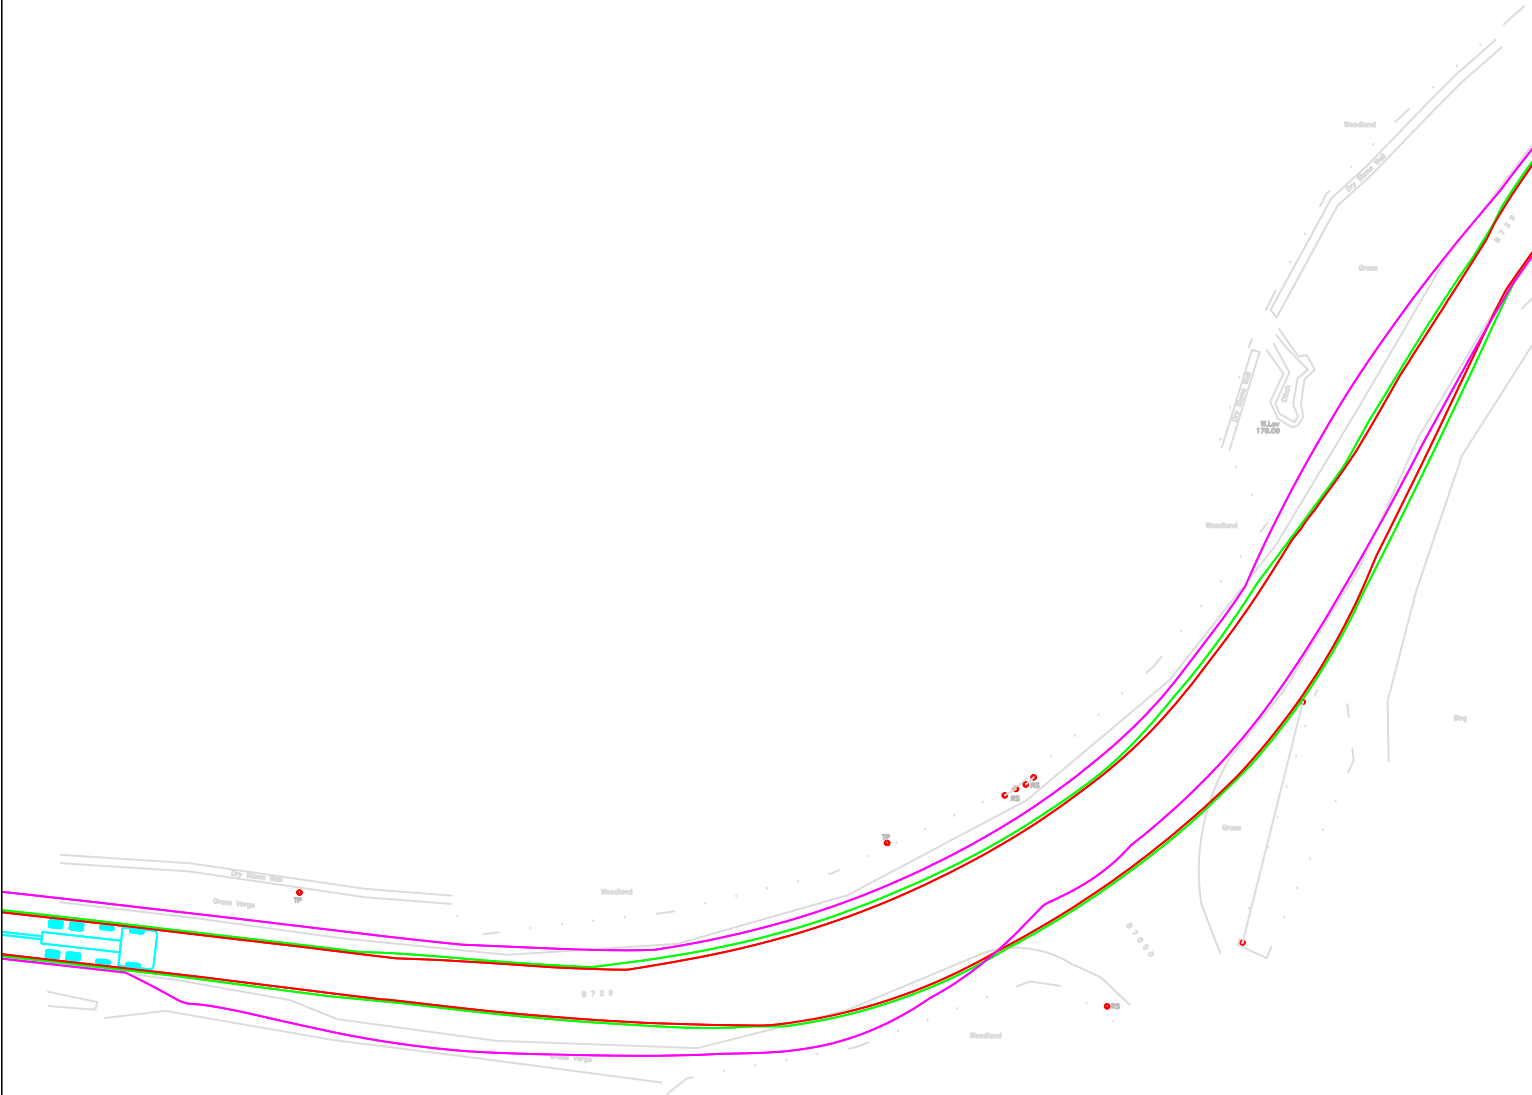

© Pell Frischmann

Pell Frischmann 93 GEORGE STREET, EDINBURGH, EH2 3ES Tel: +44 (0)131 240 1270 Email: p.fedinburgh@pellfrischmann.com www.pellfrischmann.com	Project	Appin Wind Farm		Name	Date	Scale		20612 - Appin Tracking [SG155 N163 SG170]_Part2 Final.dwg			
			Drawn	GLJ	15/07/2022	1:500 @ A3					
			Designed	GLJ	15/07/2022						
			Checked	GB	15/07/2022						
Client	Statkraft	Drawing Title	SG155 / N163 / SG170 Blades & 29.977 x 4.8 x 4.793 Tower			Point of Interest		83	Drawing Status		Draft
						Drawing No.		Notes:		Revision	
Key	Wheel SPA Body SPA Load SPA Indicative Over-run Over-sail	SPA Location	B729 / B700 Junction			SK52B		1. All mitigation is subject to confirmation through a test run. 2. This is not a construction drawing and is intended for illustration purposes only.		1	


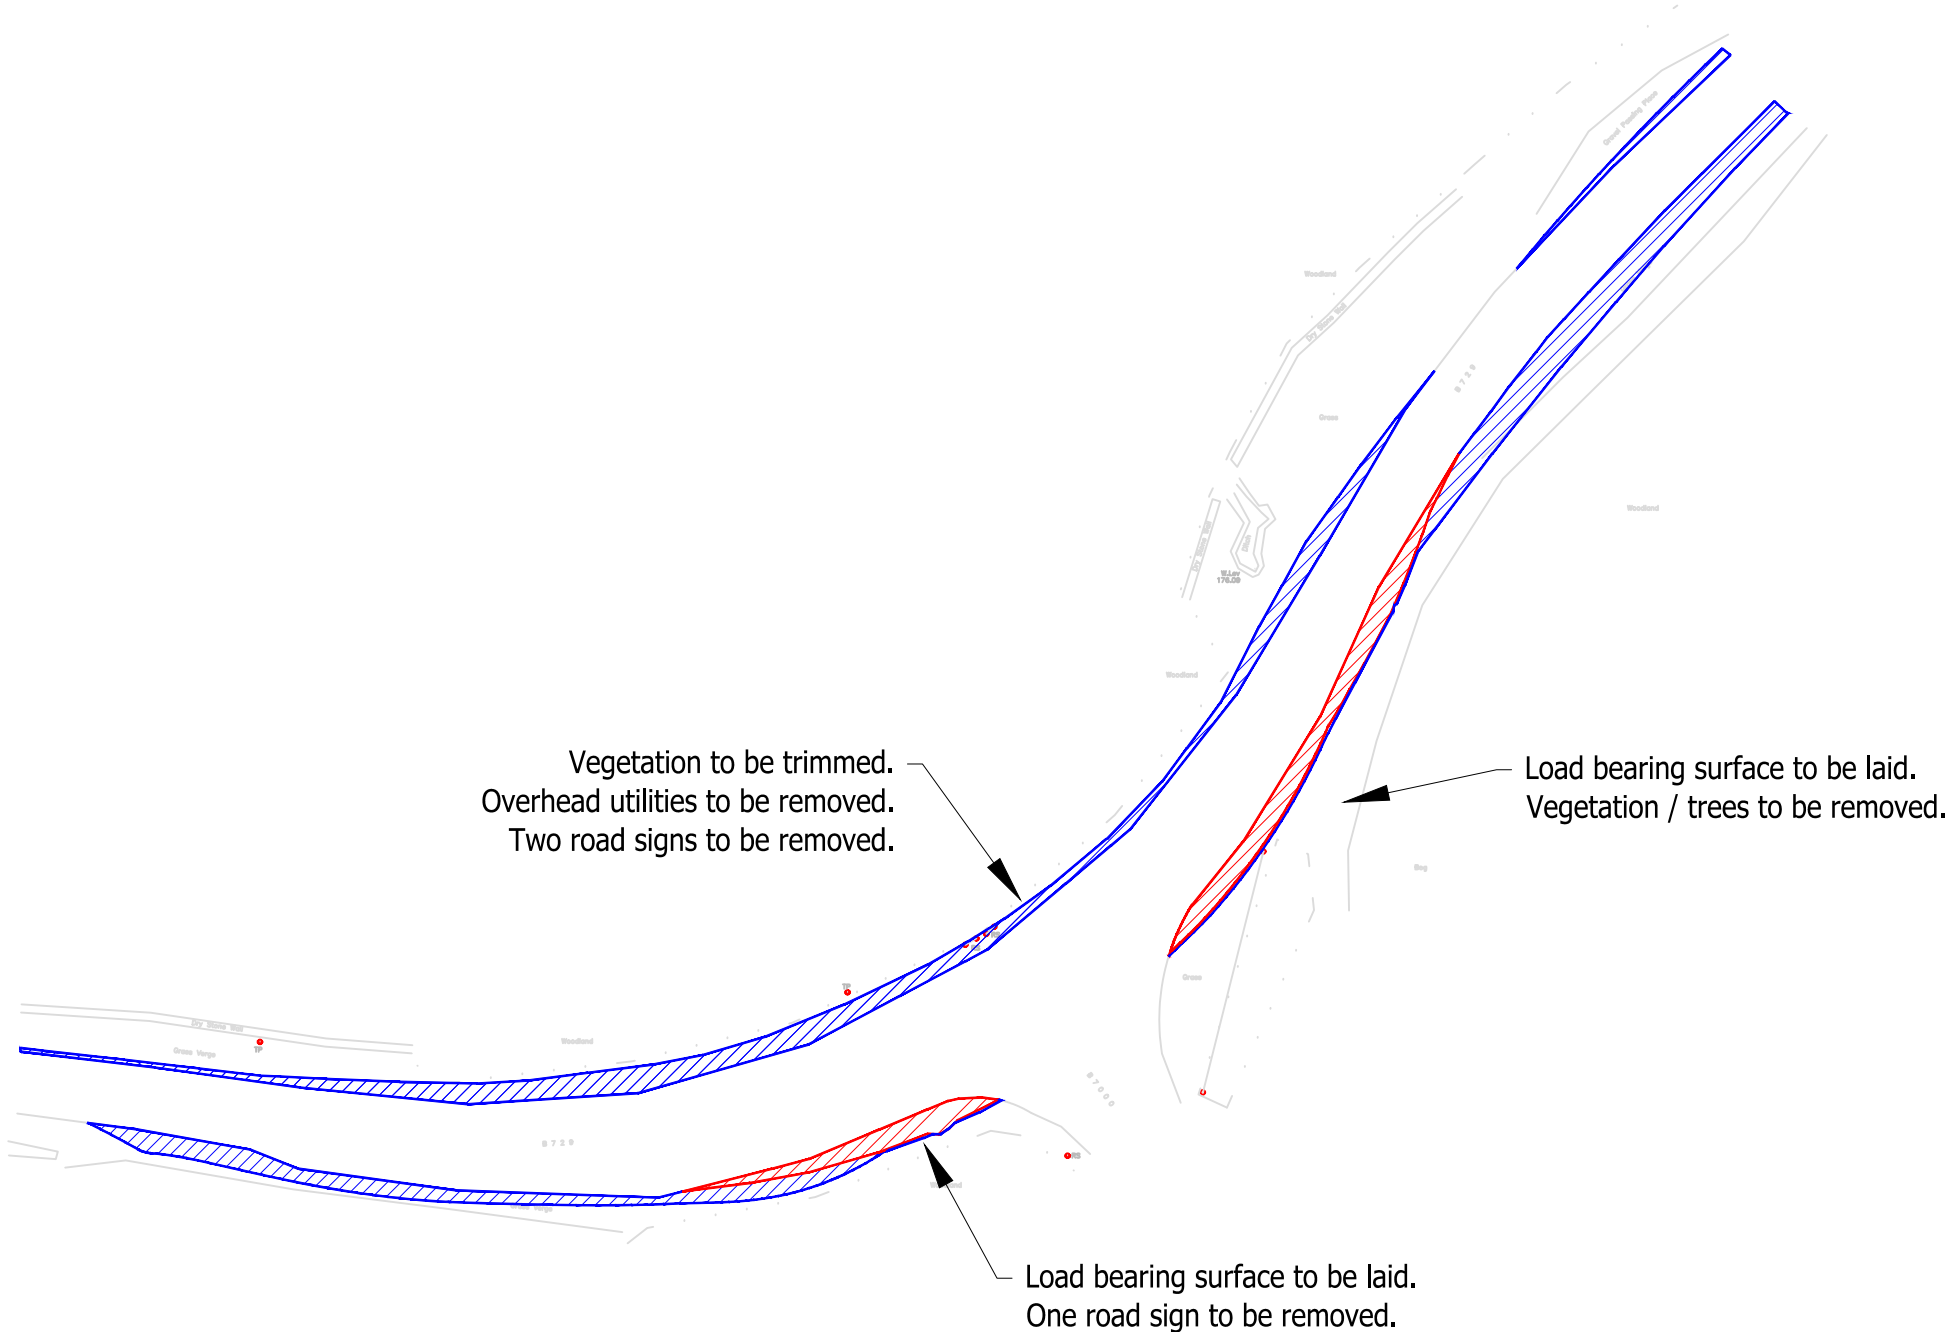


© Pell Frischmann

Pell Frischmann 93 GEORGE STREET, EDINBURGH, EH2 3ES Tel: +44 (0) 131 240 1270 Email: pfredinburgh@pellfrischmann.com www.pellfrischmann.com		Project Appin Wind Farm			Name	Date	Scale	
				Drawn	GLJ	15/07/2022	1:500 @ A3	
				Designed	GLJ	15/07/2022	220622 - Appin Tracking [SG155 N163 SG170]_Part2	
				Checked	GB	15/07/2022	Final.dwg	
Client Statkraft		Drawing Title SG155 / N163 / SG170 Blades & 29.977 x 4.8 x 4.793 Tower		Point of Interest		83	Drawing Status	
				Drawing No.		SK52C	Revision	
Key Wheel SPA Body SPA Load SPA Indicative Over-run Over-sail		SPA Location B729 / B700 Junction		Notes:				
				1. All mitigation is subject to confirmation through a test run. 2. This is not a construction drawing and is intended for illustration purposes only.				1


SG170 Blade

Tower

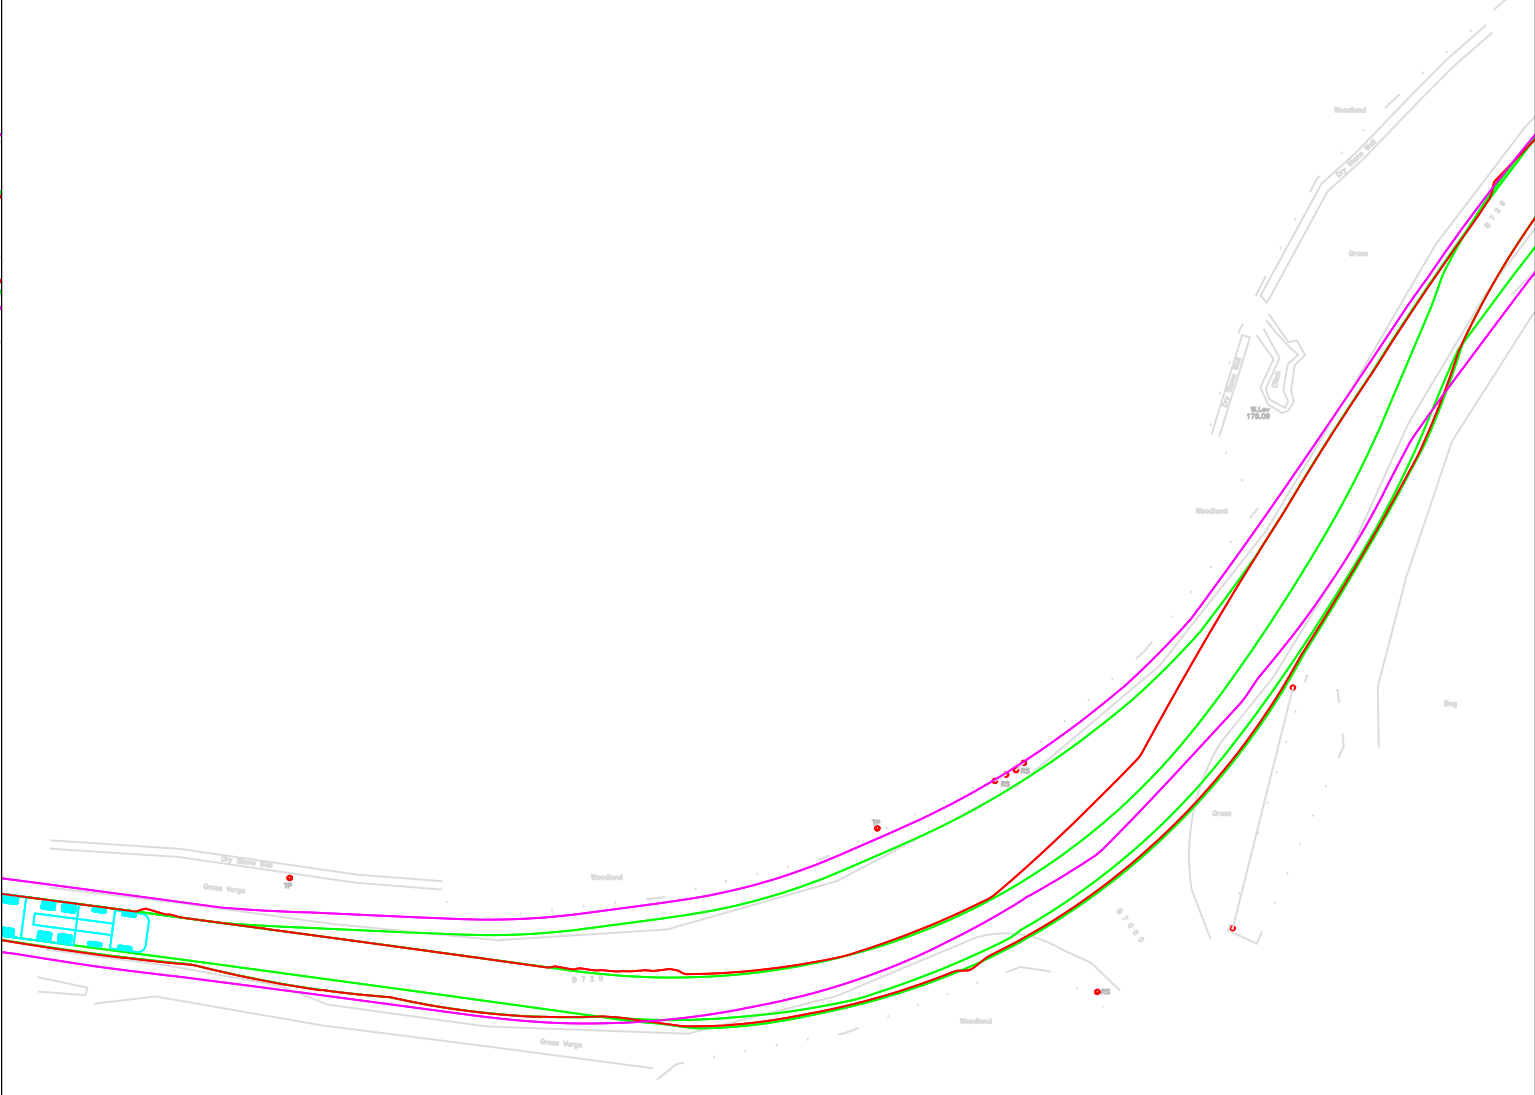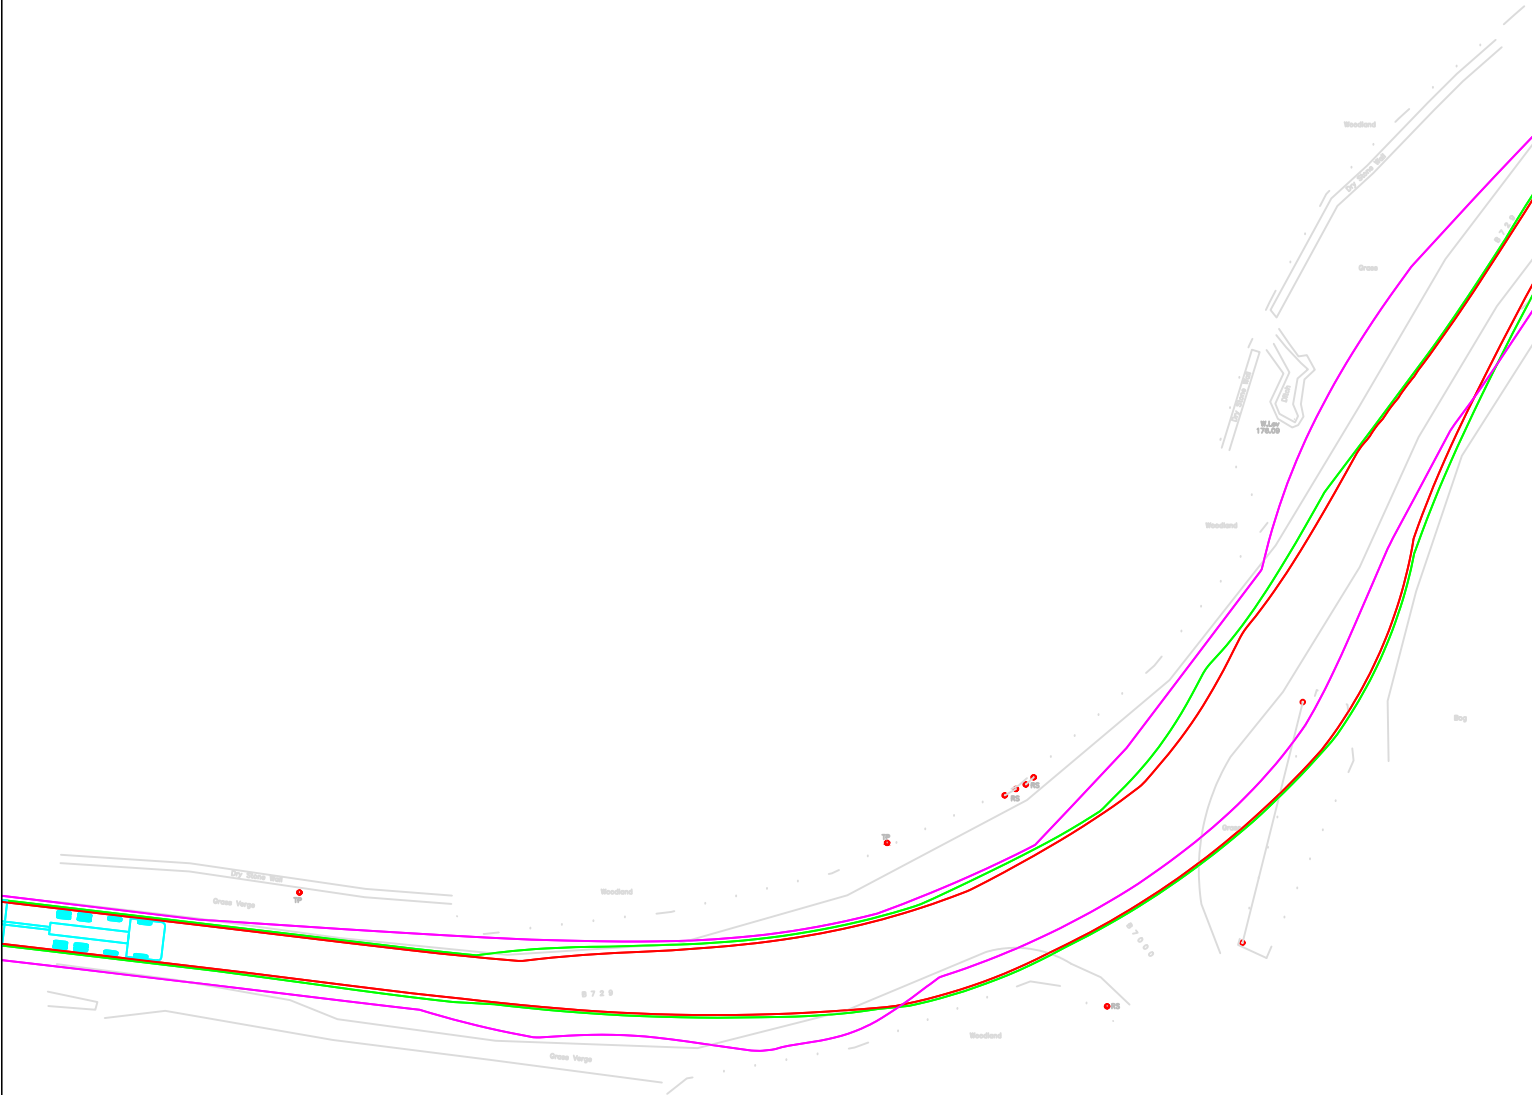

© Pell Frischmann


Pell Frischmann 93 GEORGE STREET, EDINBURGH, EH2 3ES Tel: +44 (0)131 240 1270 Email: pfredinburgh@pellfrischmann.com www.pellfrischmann.com	Client	Statkraft	Project	Appin Wind Farm			Name	Date	Scale	
							GLJ	15/07/2022	1:500 @ A3	
							GLJ	15/07/2022	220622 - Appin Tracking [SG155 N163 SG170]_Part2	
							GB	15/07/2022	Final.dwg	
Key Wheel SPA Body SPA Load SPA Indicative Over-run Over-sail			Drawing Title	SG155 / N163 / SG170 Blades & 29.977 x 4.8 x 4.793 Tower	Point of Interest		83		Drawing Status	
					SPA Location	B729 / B700 Junction	DRAFT		Revision	
							1		1	

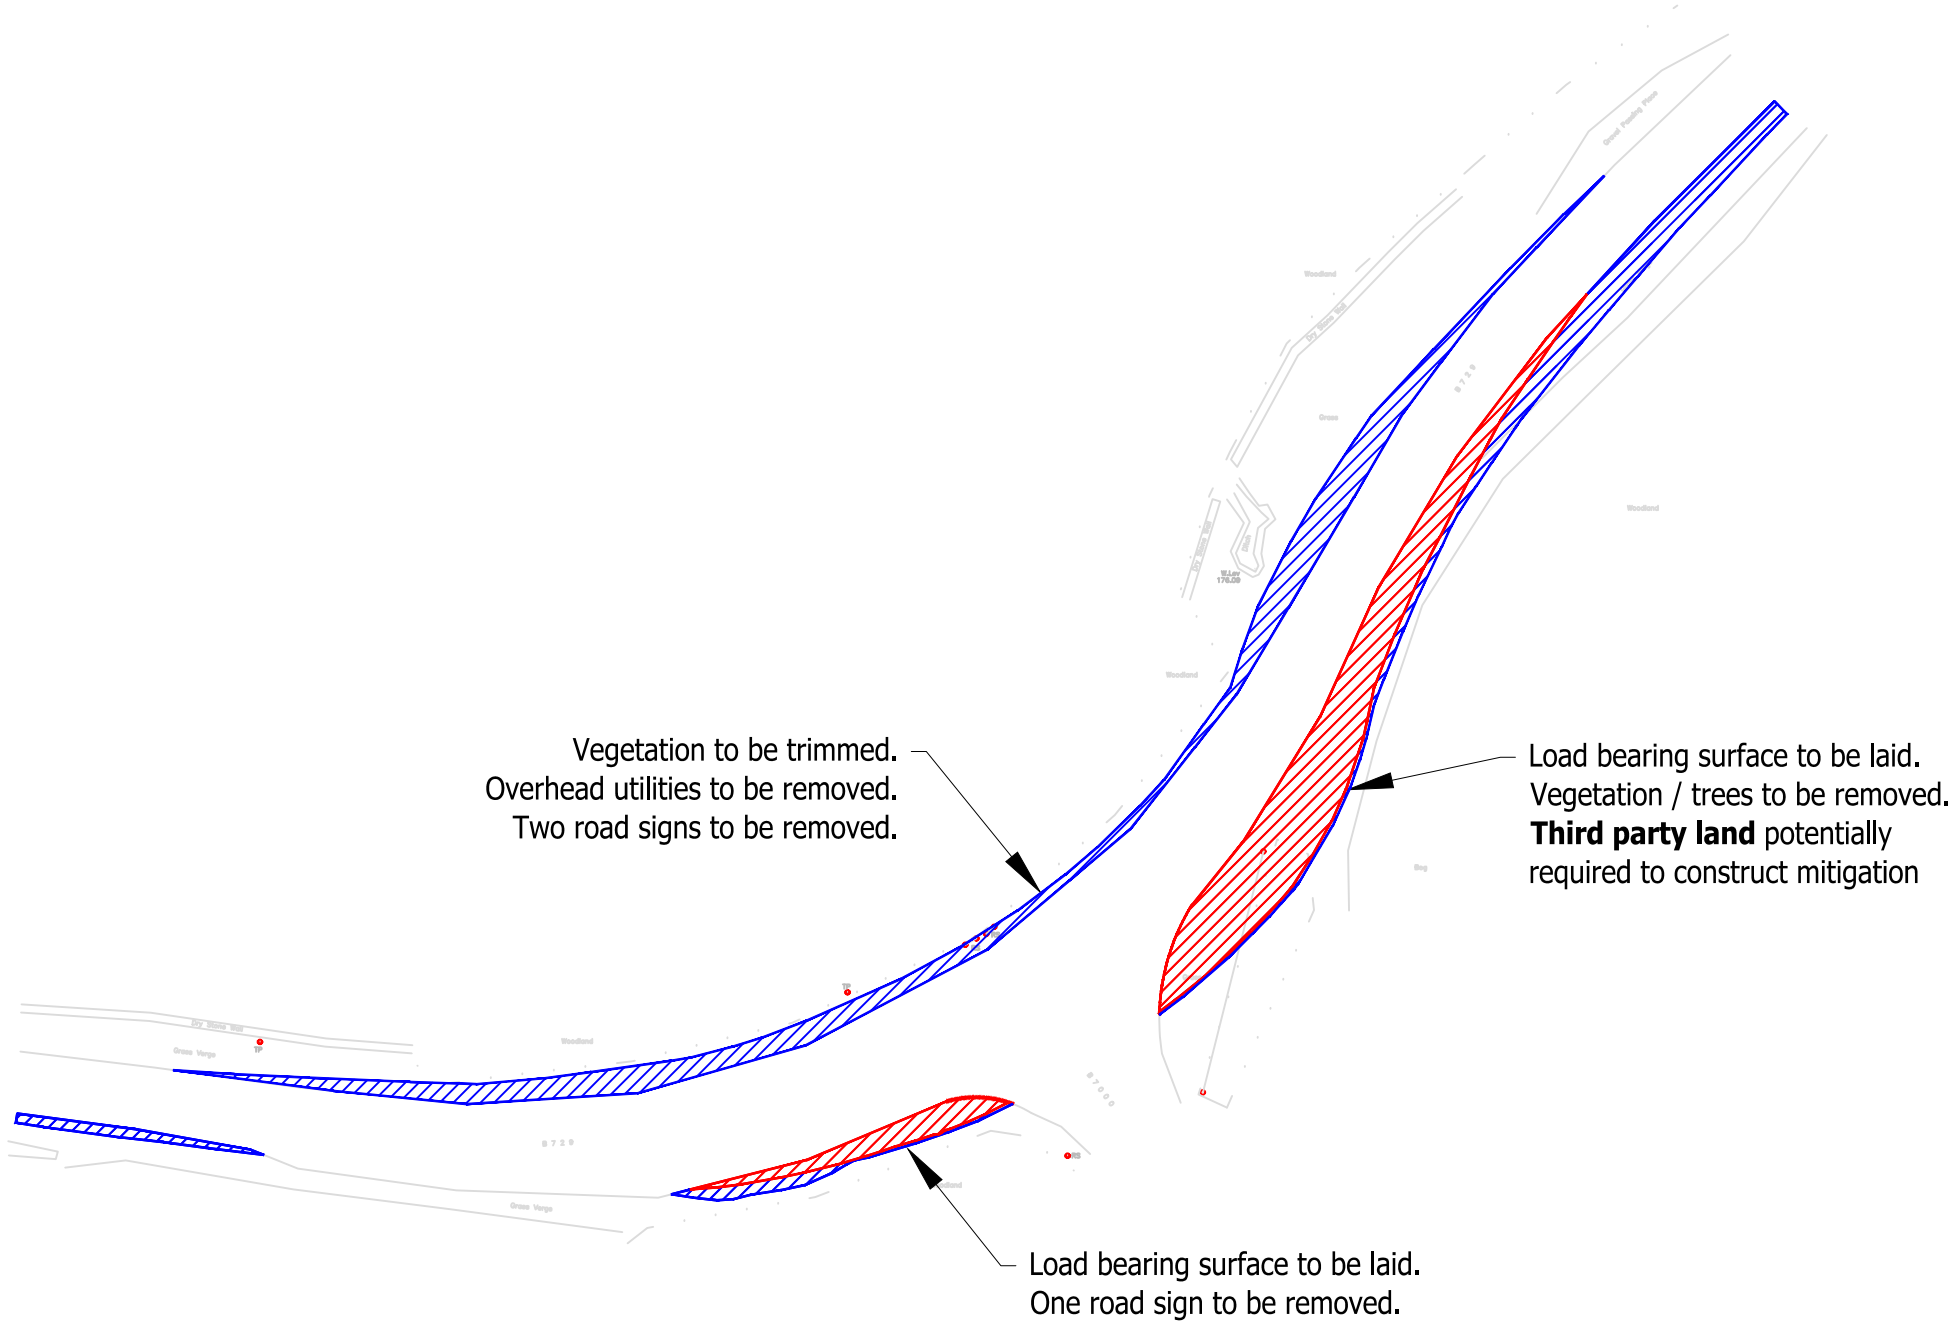


© Pell Frischmann

Pell Frischmann 93 GEORGE STREET, EDINBURGH, EH2 3ES Tel: +44 (0)131 240 1270 Email: pfedinburgh@pellfrischmann.com www.pellfrischmann.com	Project	Appin Wind Farm			Name	Date	Scale		
				Drawn	GLJ	15/07/2022	1:500 @ A3		
				Designed	GLJ	15/07/2022	220622 - Appin Tracking [SG155 N163 SG170]_Part2		
				Checked	GB	15/07/2022	Final.dwg		
Client	Statkraft	Drawing Title	SG155 / N163 / SG170 Blades & 29.977 x 4.8 x 4.793 Tower		Point of Interest		83	Drawing Status	
					Draft		Draft		
Key	Wheel SPA Body SPA Load SPA Indicative Over-run Over-sail	SPA Location	B729 / B700 Junction		Drawing No.	SK52E	Notes:		Revision
							1. All mitigation is subject to confirmation through a test run. 2. This is not a construction drawing and is intended for illustration purposes only.		

SG155 Blade

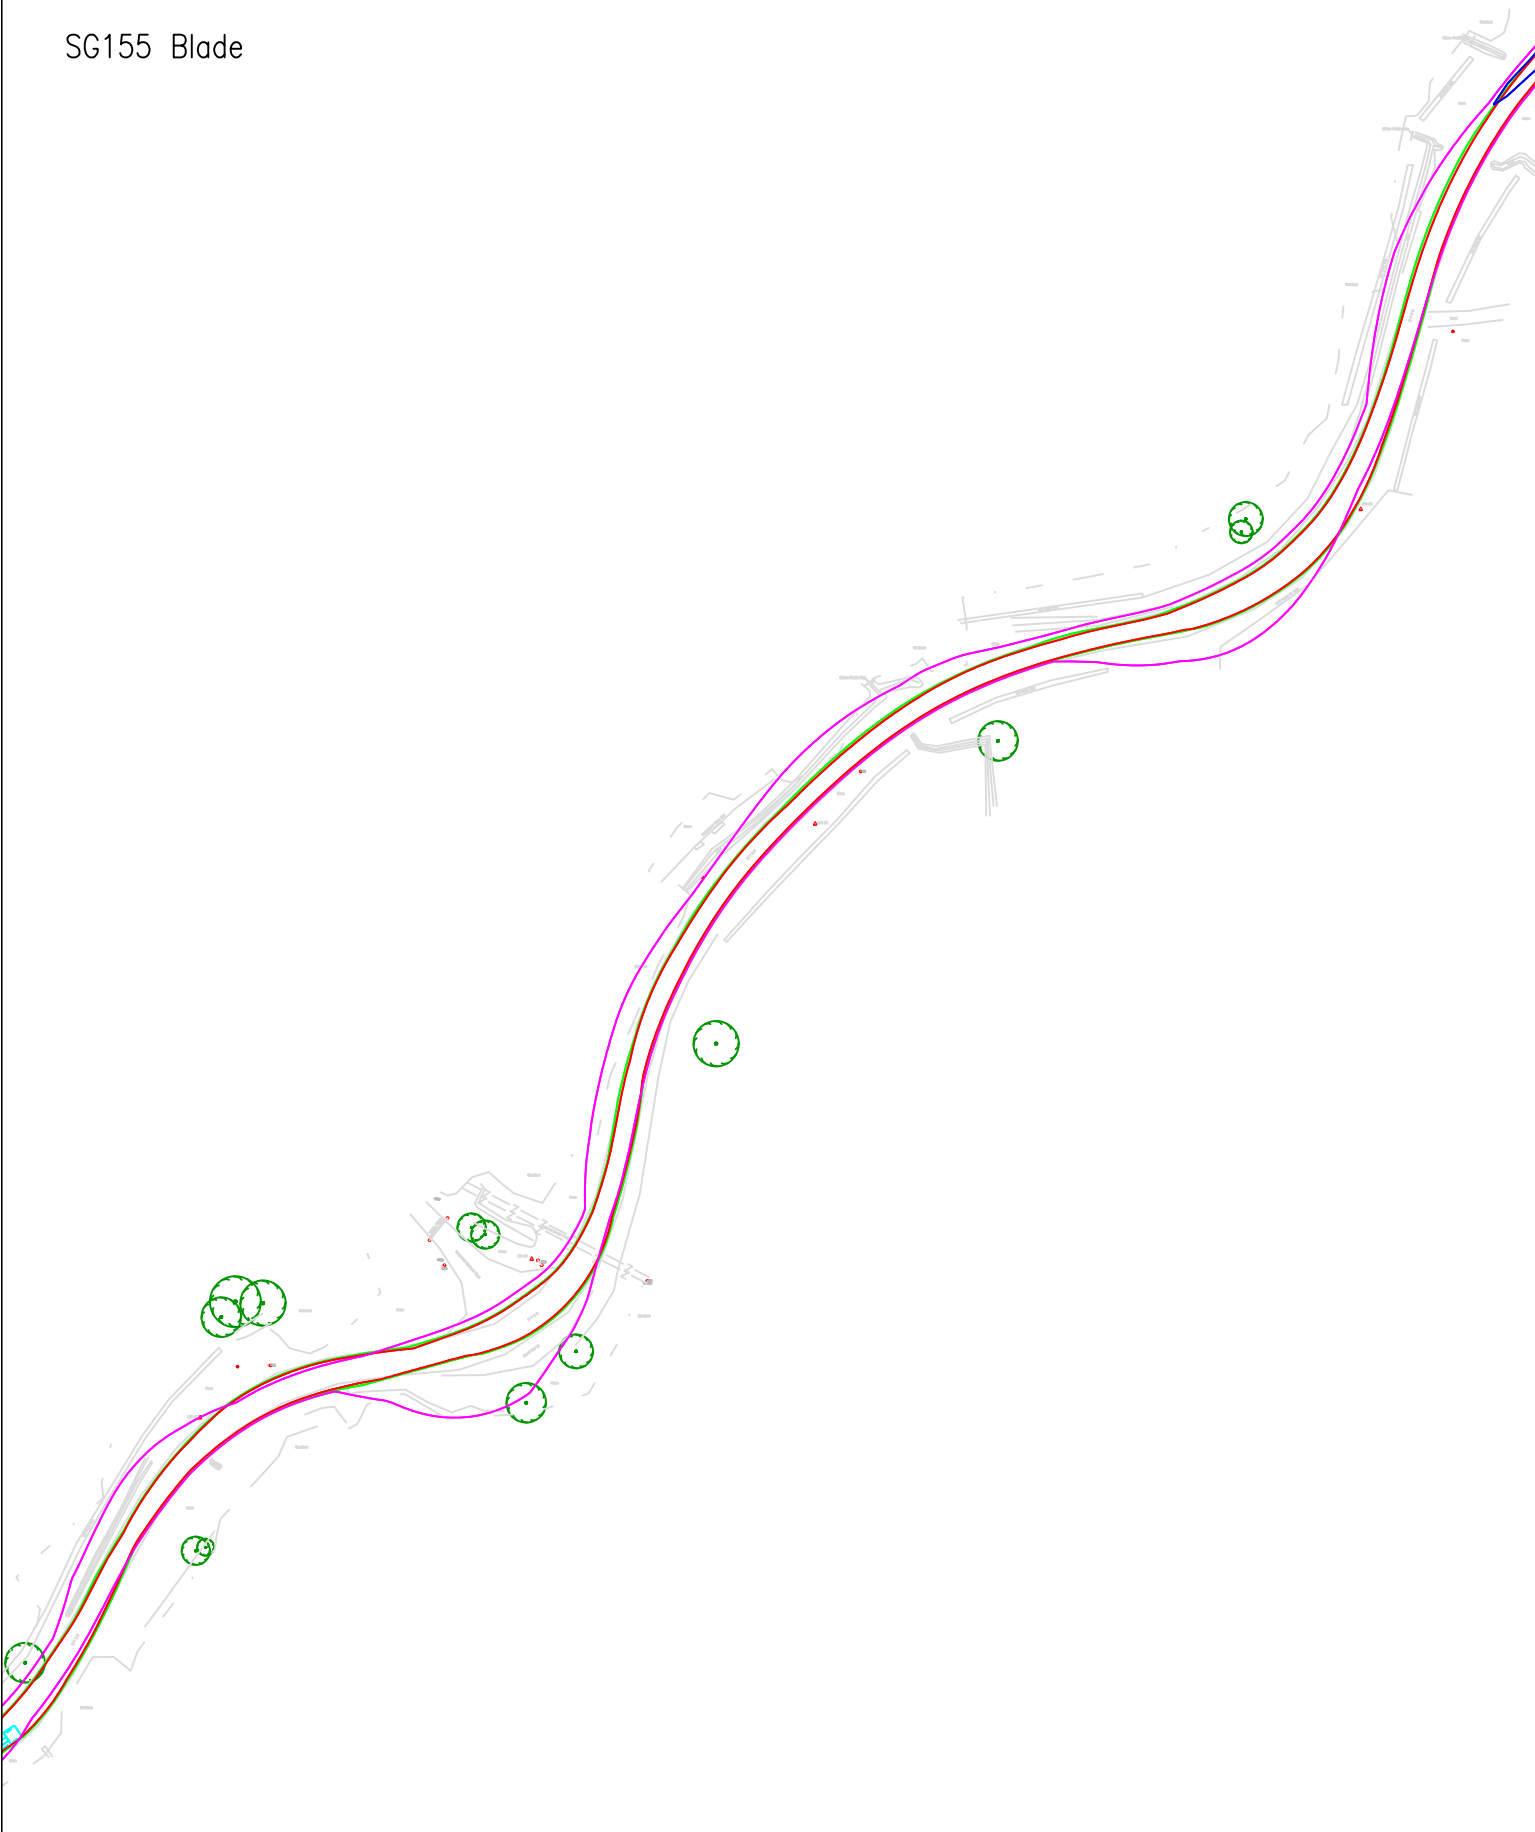


Tower

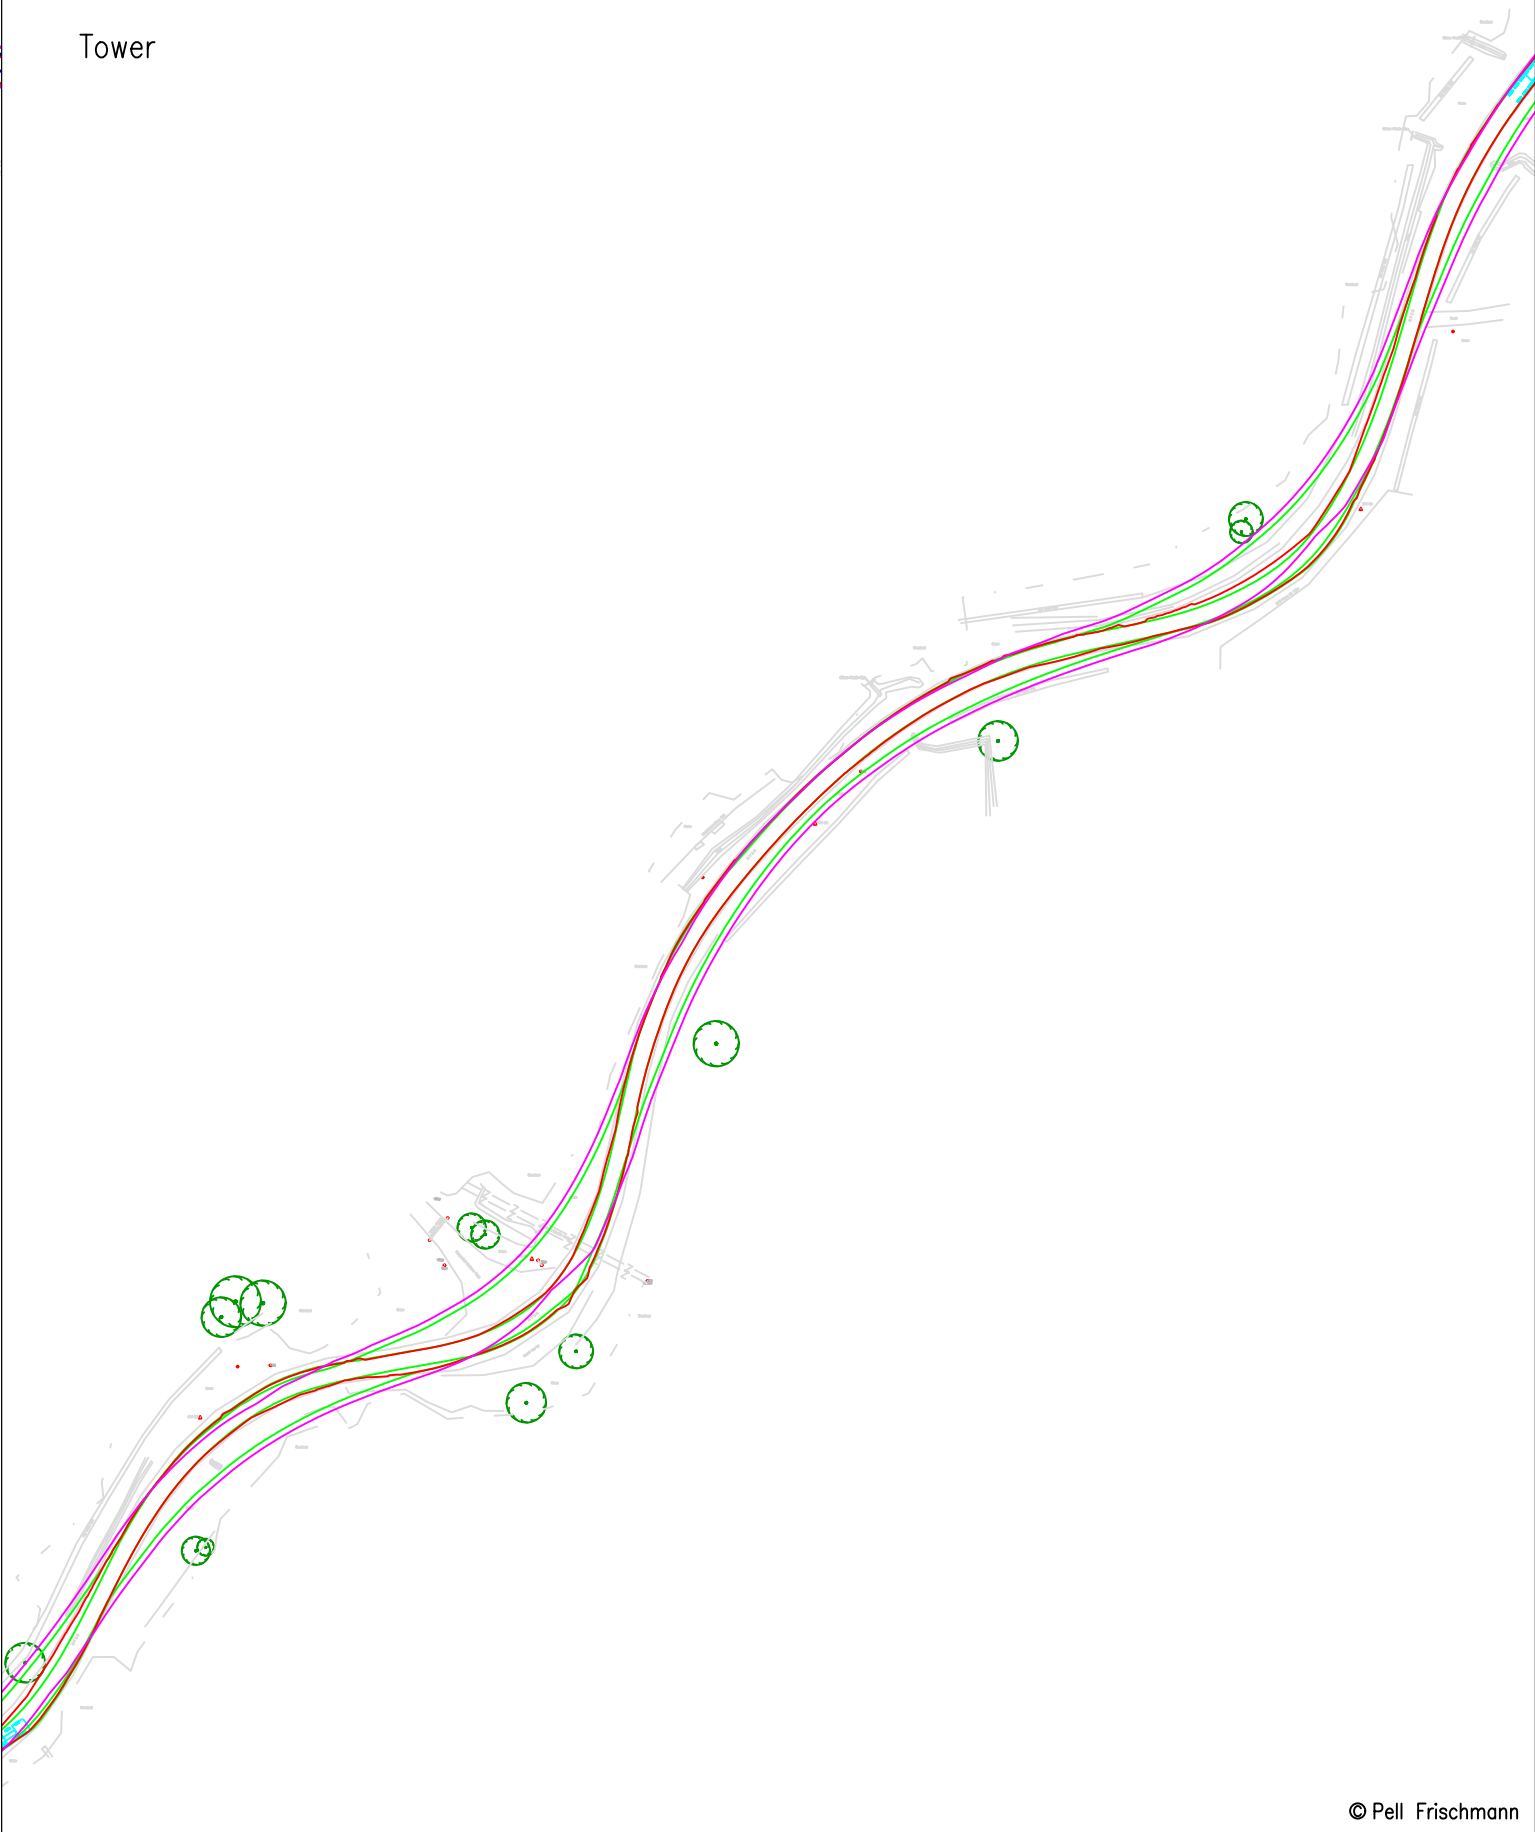

© Pell Frischmann

Pell Frischmann 93 GEORGE STREET, EDINBURGH, EH2 3ES Tel: +44 (0)131 240 1270 Email: pfedinburgh@pellfrischmann.com www.pellfrischmann.com	Project	Appin Wind Farm		Name	Date	Scale	
			Drawn	GLJ	15/07/2022	1:1500 @ A3	
			Designed	GLJ	15/07/2022	20620 - Appin Tracking [SG155 N163 SG170]_Part2	
			Checked	GB	15/07/2022	Final.dwg	
Client	Drawing Title	SG155 / N163 / SG170 Blades & 29.977 x 4.8 x 4.793 Tower	Point of Interest		84,85	Drawing Status	
						Draft	
Key	SPA Location	B729 Bends at Muirdrochwood	Drawing No.	SK53	Notes:		Revision
					1. All mitigation is subject to confirmation through a test run. 2. This is not a construction drawing and is intended for illustration purposes only.		
Wheel SPA Body SPA Load SPA Indicative Over-run Over-sail							1

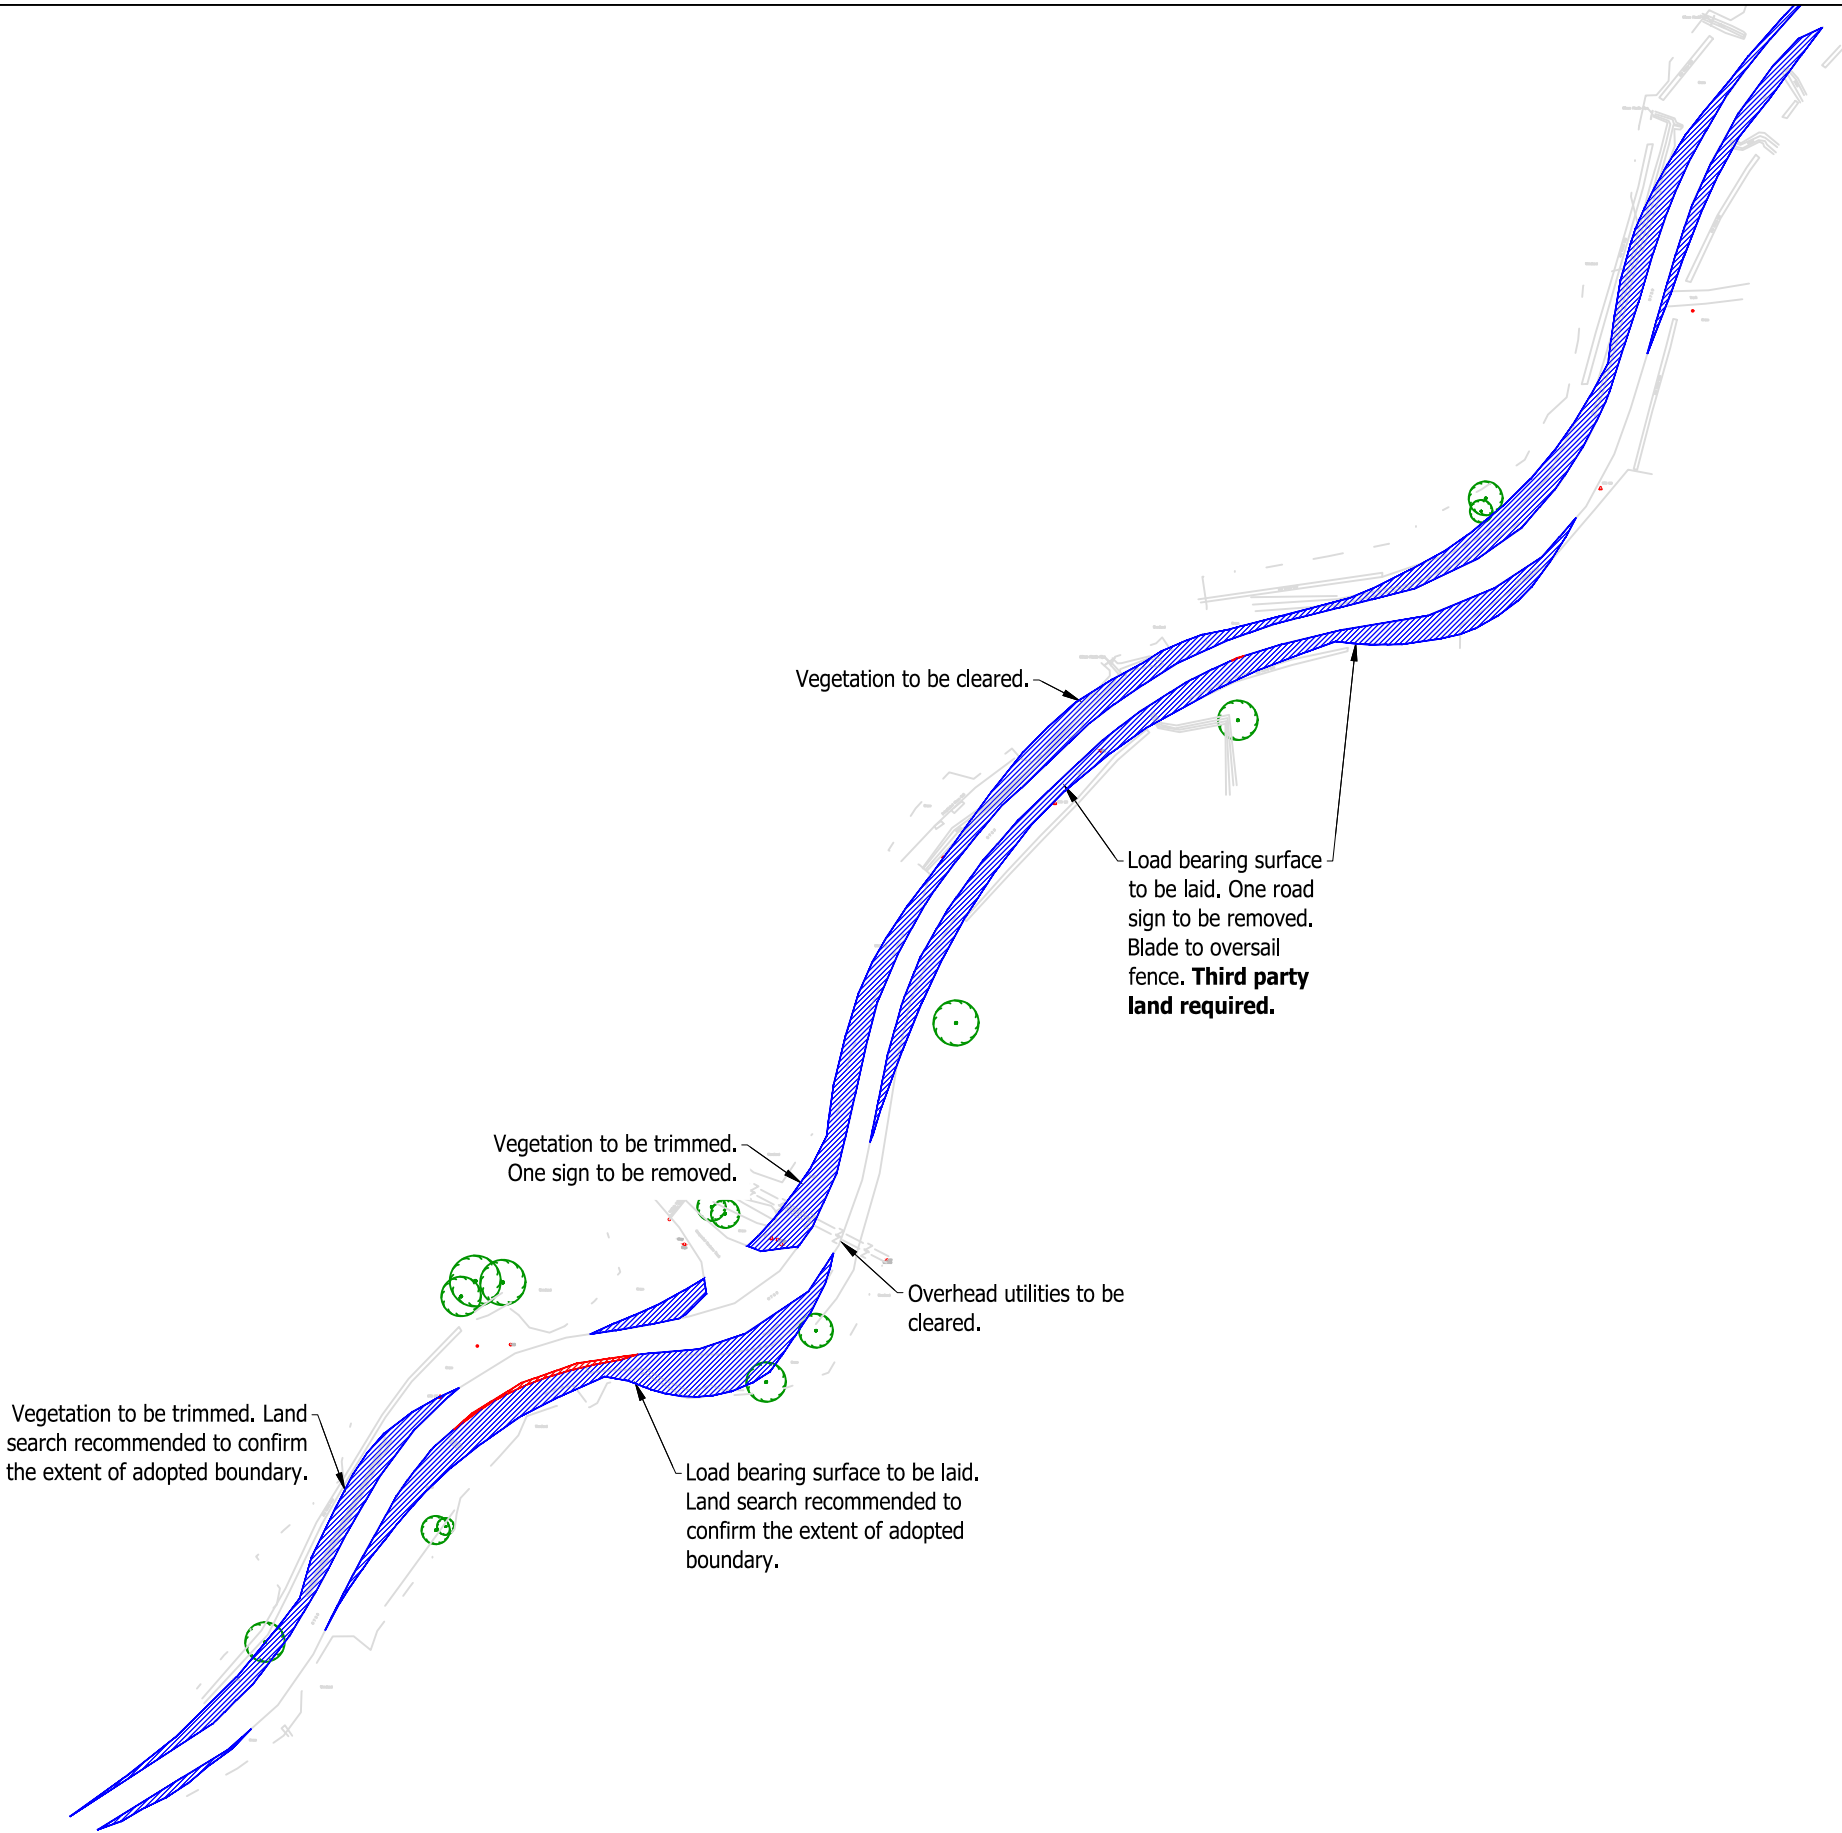

© Pell Frischmann


Pell Frischmann 93 GEORGE STREET, EDINBURGH, EH2 3ES Tel: +44 (0)131 240 1270 Email: p.fedinburgh@pellfrischmann.com www.pellfrischmann.com	Project	Appin Wind Farm		Name	Date	Scale	
			Drawn	GLJ	15/07/2022	1:1500 @ A3	
			Designed	GLJ	15/07/2022	220622 - Appin Tracking [SG155 N163 SG170]_Part2	
			Checked	GB	15/07/2022	Final.dwg	
Client	Statkraft	Drawing Title	Point of Interest		84,85	Drawing Status	
						Draft	
Key	SPA Location	SG155 / N163 / SG170 Blades & 29.977 x 4.8 x 4.793 Tower	Drawing No.	SK53A	Notes:	Revision	
Wheel SPA Body SPA Load SPA Indicative Over-run Over-sail		B729 Marscloch Bends	1. All mitigation is subject to confirmation through a test run. 2. This is not a construction drawing and is intended for illustration purposes only.		1		

N163 Blade

Tower


© Pell Frischmann

Pell Frischmann 93 GEORGE STREET, EDINBURGH, EH2 3ES Tel: +44 (0)131 240 1270 Email: pfedinburgh@pellfrischmann.com www.pellfrischmann.com	Project		Appin Wind Farm			Name	Date	Scale		1:1500 @ A3		
					Drawn	GLJ	15/07/2022	210622-Appin Tracking [SG155 N163 SG170]_Part2				
					Designed	GLJ	15/07/2022	Final.dwg				
					Checked	GB	15/07/2022	Drawing Status		Draft		
Client	Statkraft		Drawing Title		SG155 / N163 / SG170 Blades & 29.977 x 4.8 x 4.793 Tower		Point of Interest		84,85			
Key Wheel SPA Body SPA Load SPA Indicative Over-run Over-sail			SPA Location		B729 Bends at Muirdrochwood		Drawing No.		Notes:		Revision	
							SK53B		1. All mitigation is subject to confirmation through a test run. 2. This is not a construction drawing and is intended for illustration purposes only.		1	

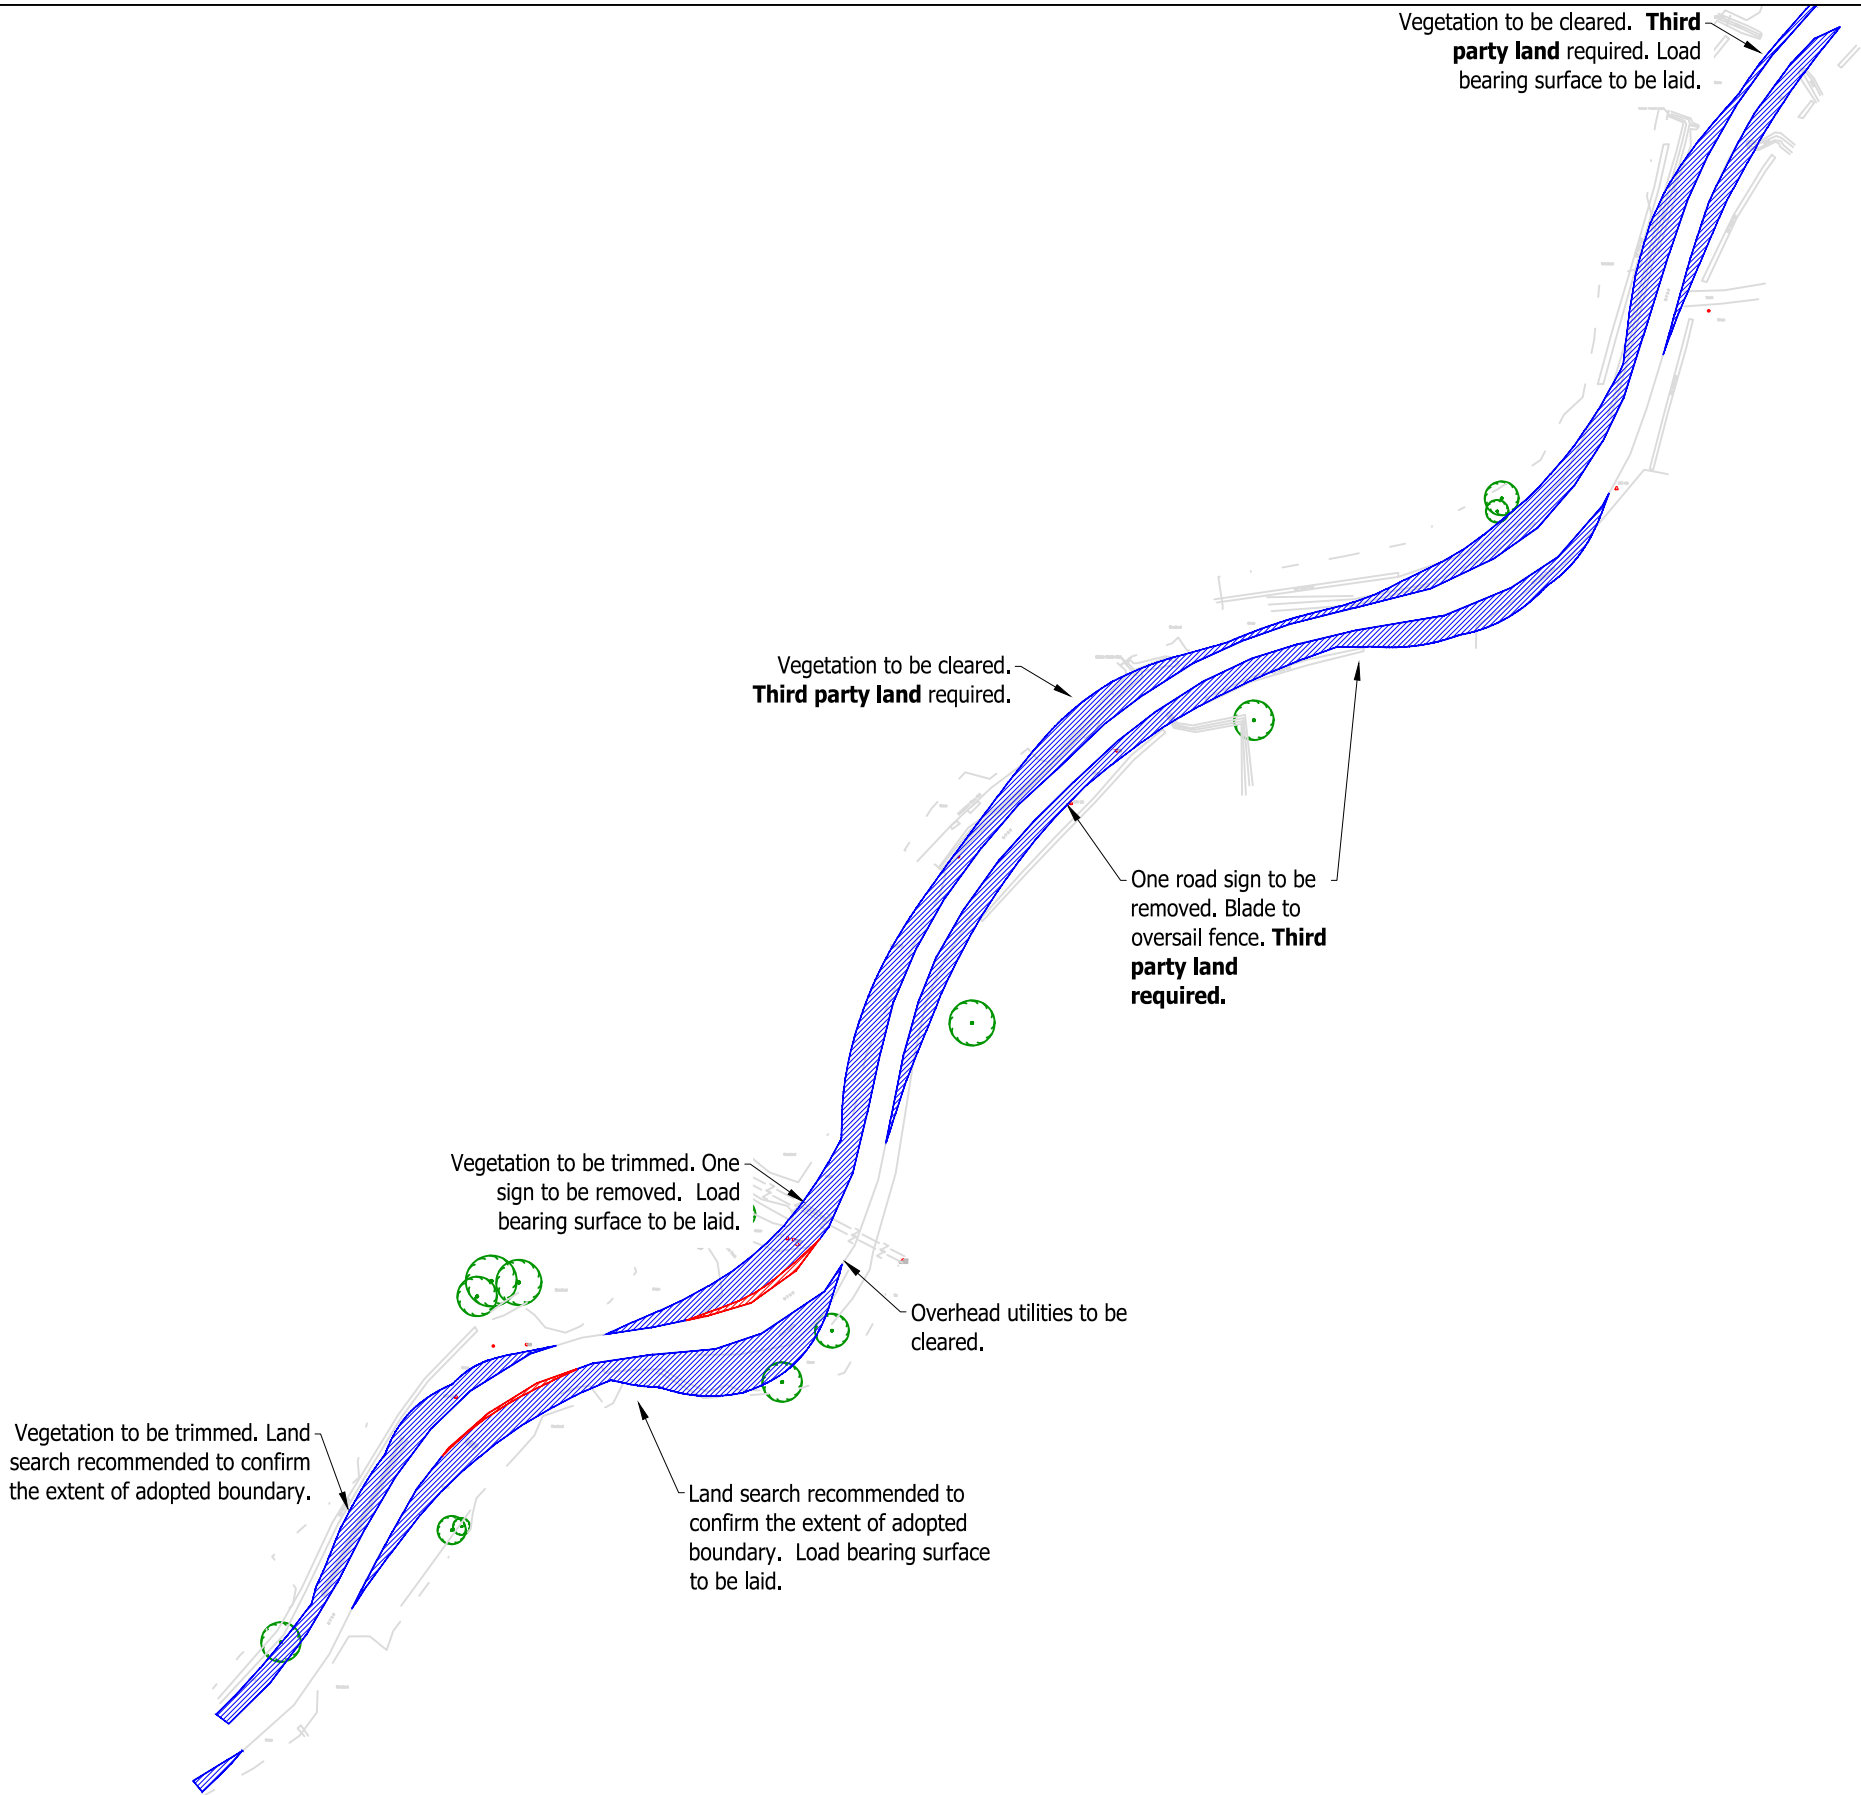


© Pell Frischmann

Pell Frischmann 93 GEORGE STREET, EDINBURGH, EH2 3ES Tel: +44 (0)131 240 1270 Email: pfredinburgh@pellfrischmann.com www.pellfrischmann.com	Project	Appin Wind Farm			Name	Date	Scale		
				Drawn	GLJ	15/07/2022	1:1500 @ A3		
				Designed	GLJ	15/07/2022	220622 - Appin Tracking [SG155 N163 SG170]_Part2		
				Checked	GB	15/07/2022	Final.dwg		
Client	Statkraft	Drawing Title	SG155 / N163 / SG170 Blades & 29.977 x 4.8 x 4.793 Tower		Point of Interest		84,85	Drawing Status	Draft
					Drawing No.	Notes:			Revision
Key	Wheel SPA Body SPA Load SPA Indicative Over-run Over-sail	SPA Location	B729 Marscloch Bends		SK53C	1. All mitigation is subject to confirmation through a test run. 2. This is not a construction drawing and is intended for illustration purposes only.			1

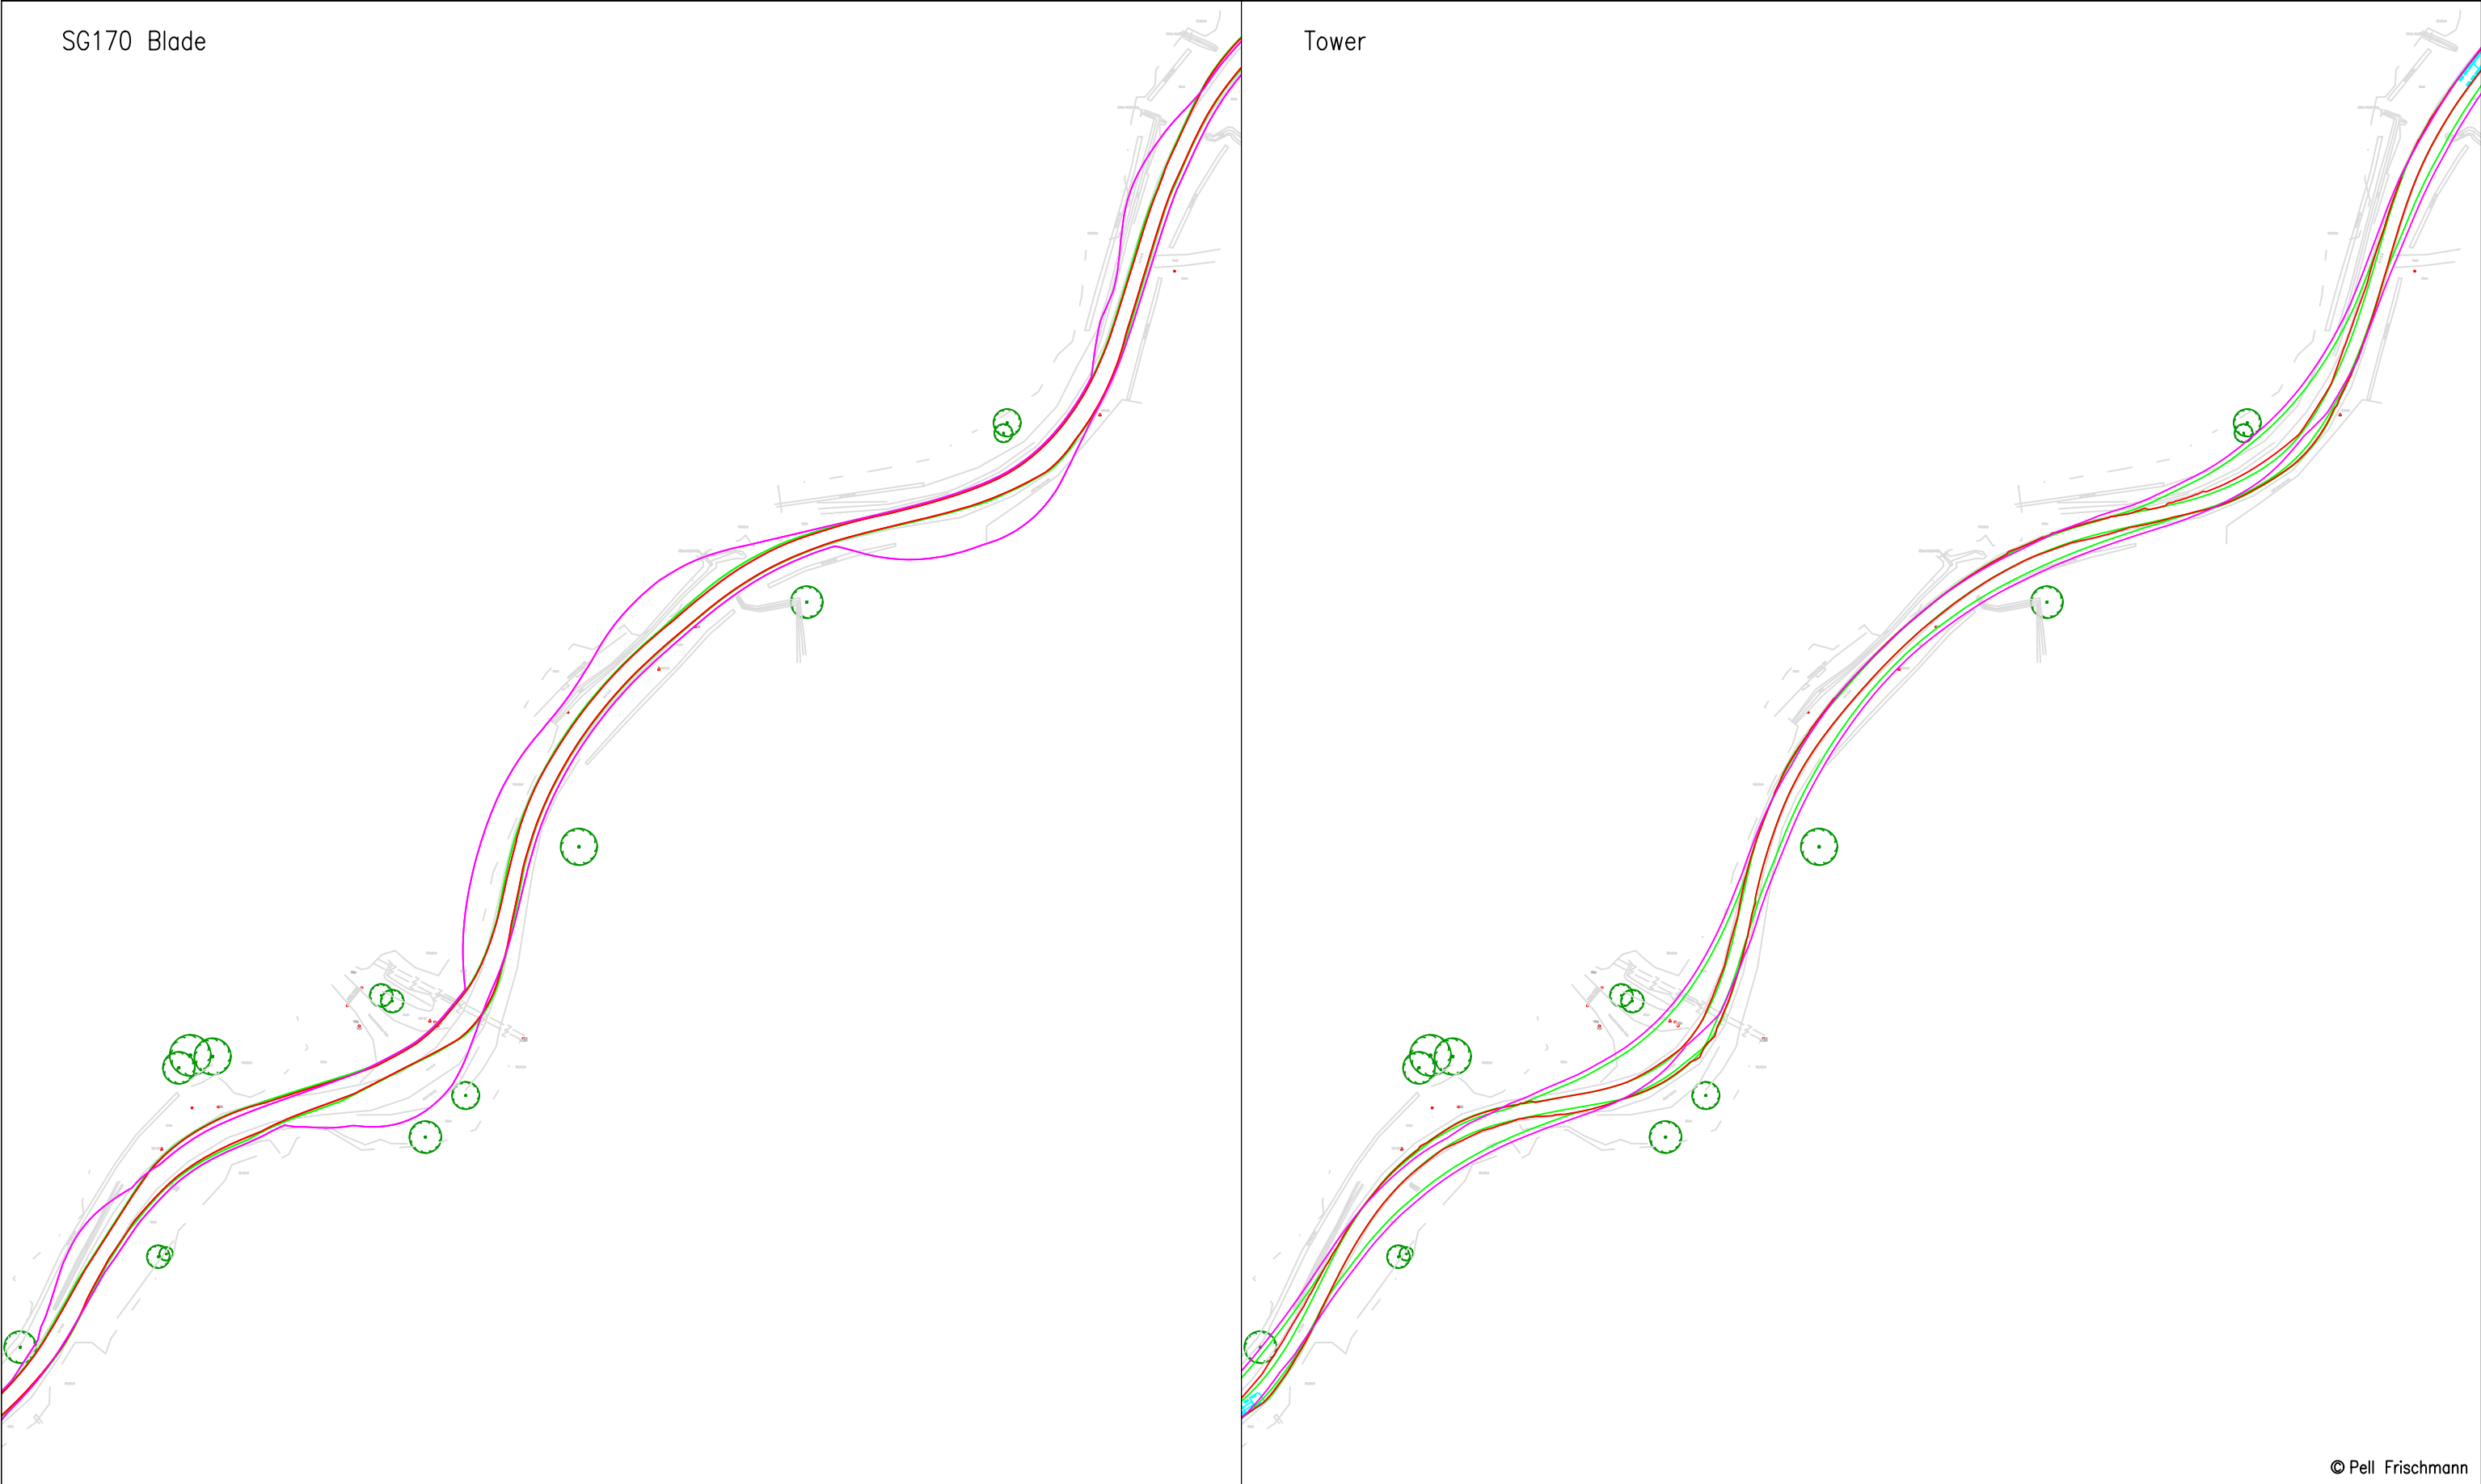


© Pell Frischmann

Pell Frischmann 93 GEORGE STREET, EDINBURGH, EH2 3ES Tel: +44 (0)131 240 1270 Email: p.fedinburgh@pellfrischmann.com www.pellfrischmann.com	Project	Appin Wind Farm		Name	Date	Scale		1:1500 @ A3
			Drawn	GLJ	15/07/2022	220620 - Appin Tracking [SG155 N163 SG170]_Part2		
			Designed	GLJ	15/07/2022	Final.dwg		
			Checked	GB	15/07/2022	Drawing Status		
Client	Drawing Title	SG155 / N163 / SG170 Blades & 29.977 x 4.8 x 4.793 Tower	Point of Interest		84,85		Draft	
			Statkraft	SPA Location	B729 Bends at Muirdrochwood	Drawing No.	Notes:	Revision
Key		SK53D	1. All mitigation is subject to confirmation through a test run. 2. This is not a construction drawing and is intended for illustration purposes only.			1		

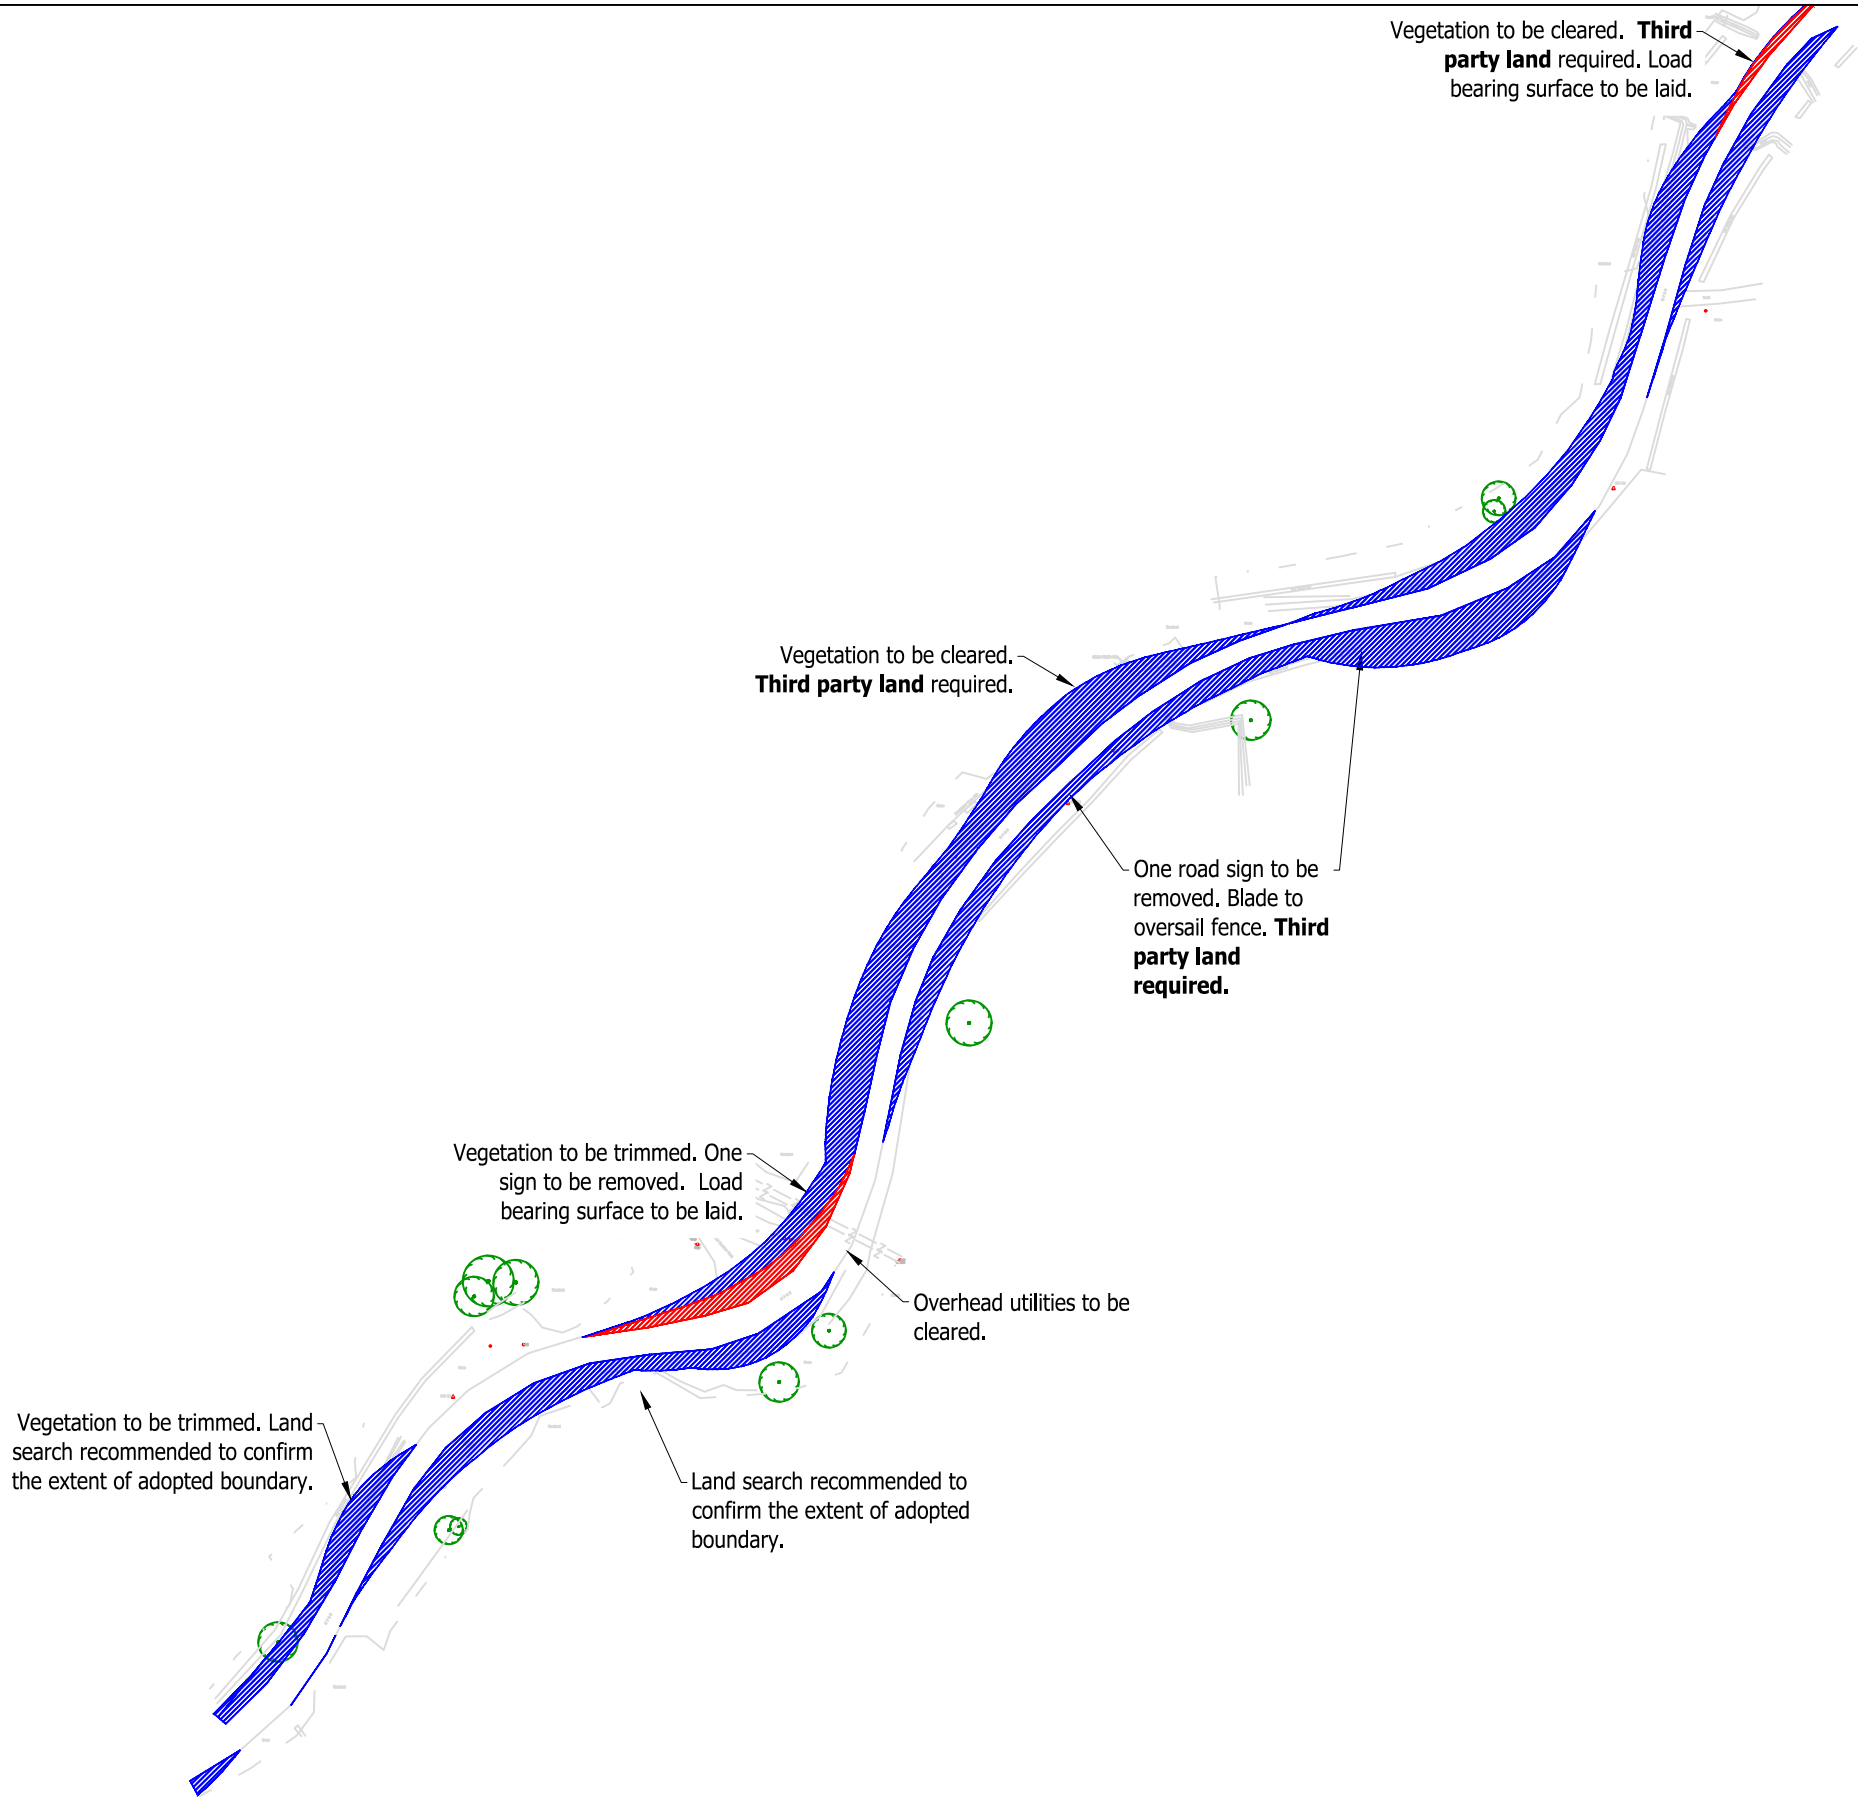

© Pell Frischmann

Pell Frischmann 93 GEORGE STREET, EDINBURGH, EH2 3ES Tel: +44 (0)131 240 1270 Email: p.fedinburgh@pellfrischmann.com www.pellfrischmann.com	Project	Appin Wind Farm			Name	Date	Scale			
				Drawn	GLJ	15/07/2022	1:1500 @ A3			
				Designed	GLJ	15/07/2022	220622 - Appin Tracking [SG155 N163 SG170]_Part2			
				Checked	GB	15/07/2022	Final.dwg			
Client	Statkraft	Drawing Title	SG155 / N163 / SG170 Blades & 29.977 x 4.8 x 4.793 Tower		Point of Interest		84,85	Drawing Status		
								Draft		
					Drawing No.		Notes:		Revision	
Key	Wheel SPA Body SPA Load SPA Indicative Over-run Over-sail	SPA Location	B729 Marscloch Bends		SK53E		1. All mitigation is subject to confirmation through a test run. 2. This is not a construction drawing and is intended for illustration purposes only.		1	

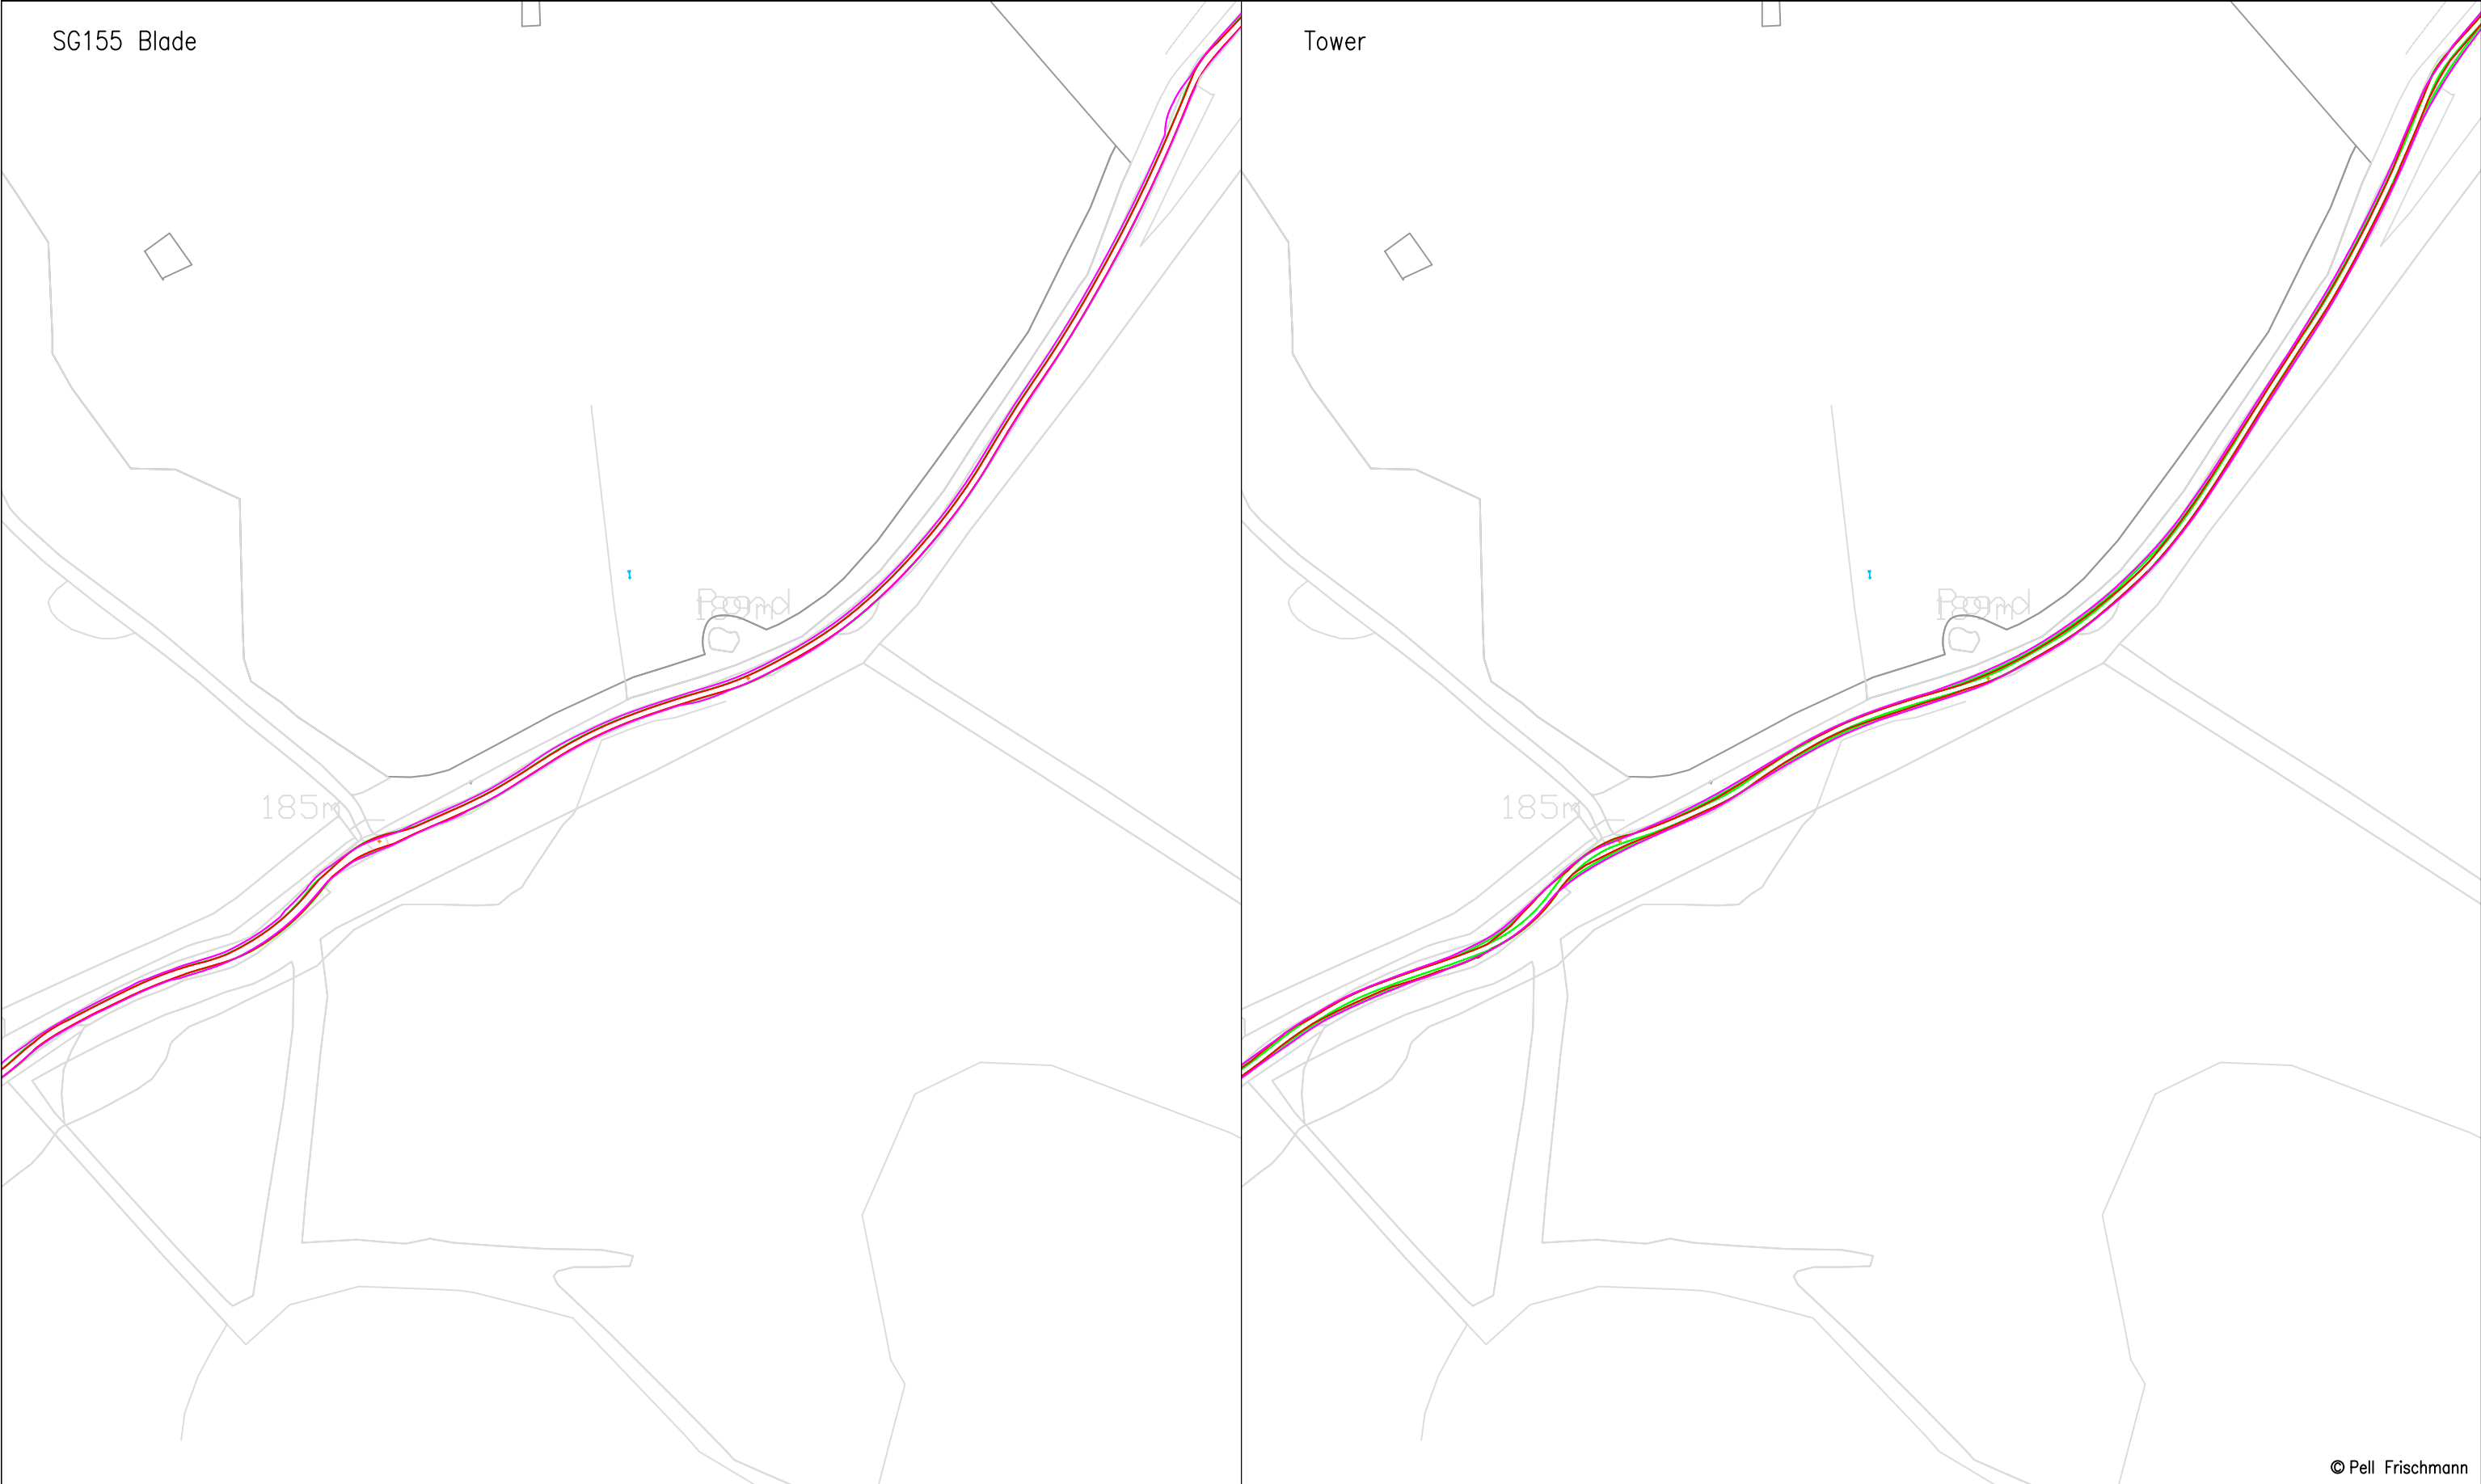


© Pell Frischmann

Pell Frischmann 93 GEORGE STREET, EDINBURGH, EH2 3ES Tel: +44 (0)131 240 1270 Email: pfedinburgh@pellfrischmann.com www.pellfrischmann.com	Project Appin Wind Farm			Name	Date	Scale 1:1500 @ A3	
			Drawn	GLJ	15/07/2022	220620 - Appin Tracking [SG155 N163 SG170]_Part2	
			Designed	GLJ	15/07/2022	Final.dwg	
			Checked	GB	15/07/2022	Drawing Status Draft	
Client Statkraft	Drawing Title SG155 / N163 / SG170 Blades & 29.977 x 4.8 x 4.793 Tower		Point of Interest		86,87,88,89		Revision 1
			Drawing No. SK54		Notes: 1. All mitigation is subject to confirmation through a test run. 2. This is not a construction drawing and is intended for illustration purposes only.		
Key Wheel SPA Body SPA Load SPA Indicative Over-run Over-sail	SPA Location B729 Bends at Muirdrochwood						




© Pell Frischmann

Pell Frischmann 93 GEORGE STREET, EDINBURGH, EH2 3ES Tel: +44 (0)131 240 1270 Email: pfedinburgh@pellfrischmann.com www.pellfrischmann.com	Project Appin Wind Farm			Name	Date	Scale 1:1500 @ A3	
			Drawn	GLJ	15/07/2022	20620 - Appin Tracking [SG155 N163 SG170]_Part2	
			Designed	GLJ	15/07/2022	Final.dwg	
			Checked	GB	15/07/2022	Drawing Status Draft	
Client Statkraft	Drawing Title SG155 / N163 / SG170 Blades & 29.977 x 4.8 x 4.793 Tower		Point of Interest		86,87,88,89		Revision 1
			Drawing No. SK54A		Notes: 1. All mitigation is subject to confirmation through a test run. 2. This is not a construction drawing and is intended for illustration purposes only.		
Key	Wheel SPA	Body SPA	Load SPA	Indicative	Over-run	Over-sail	

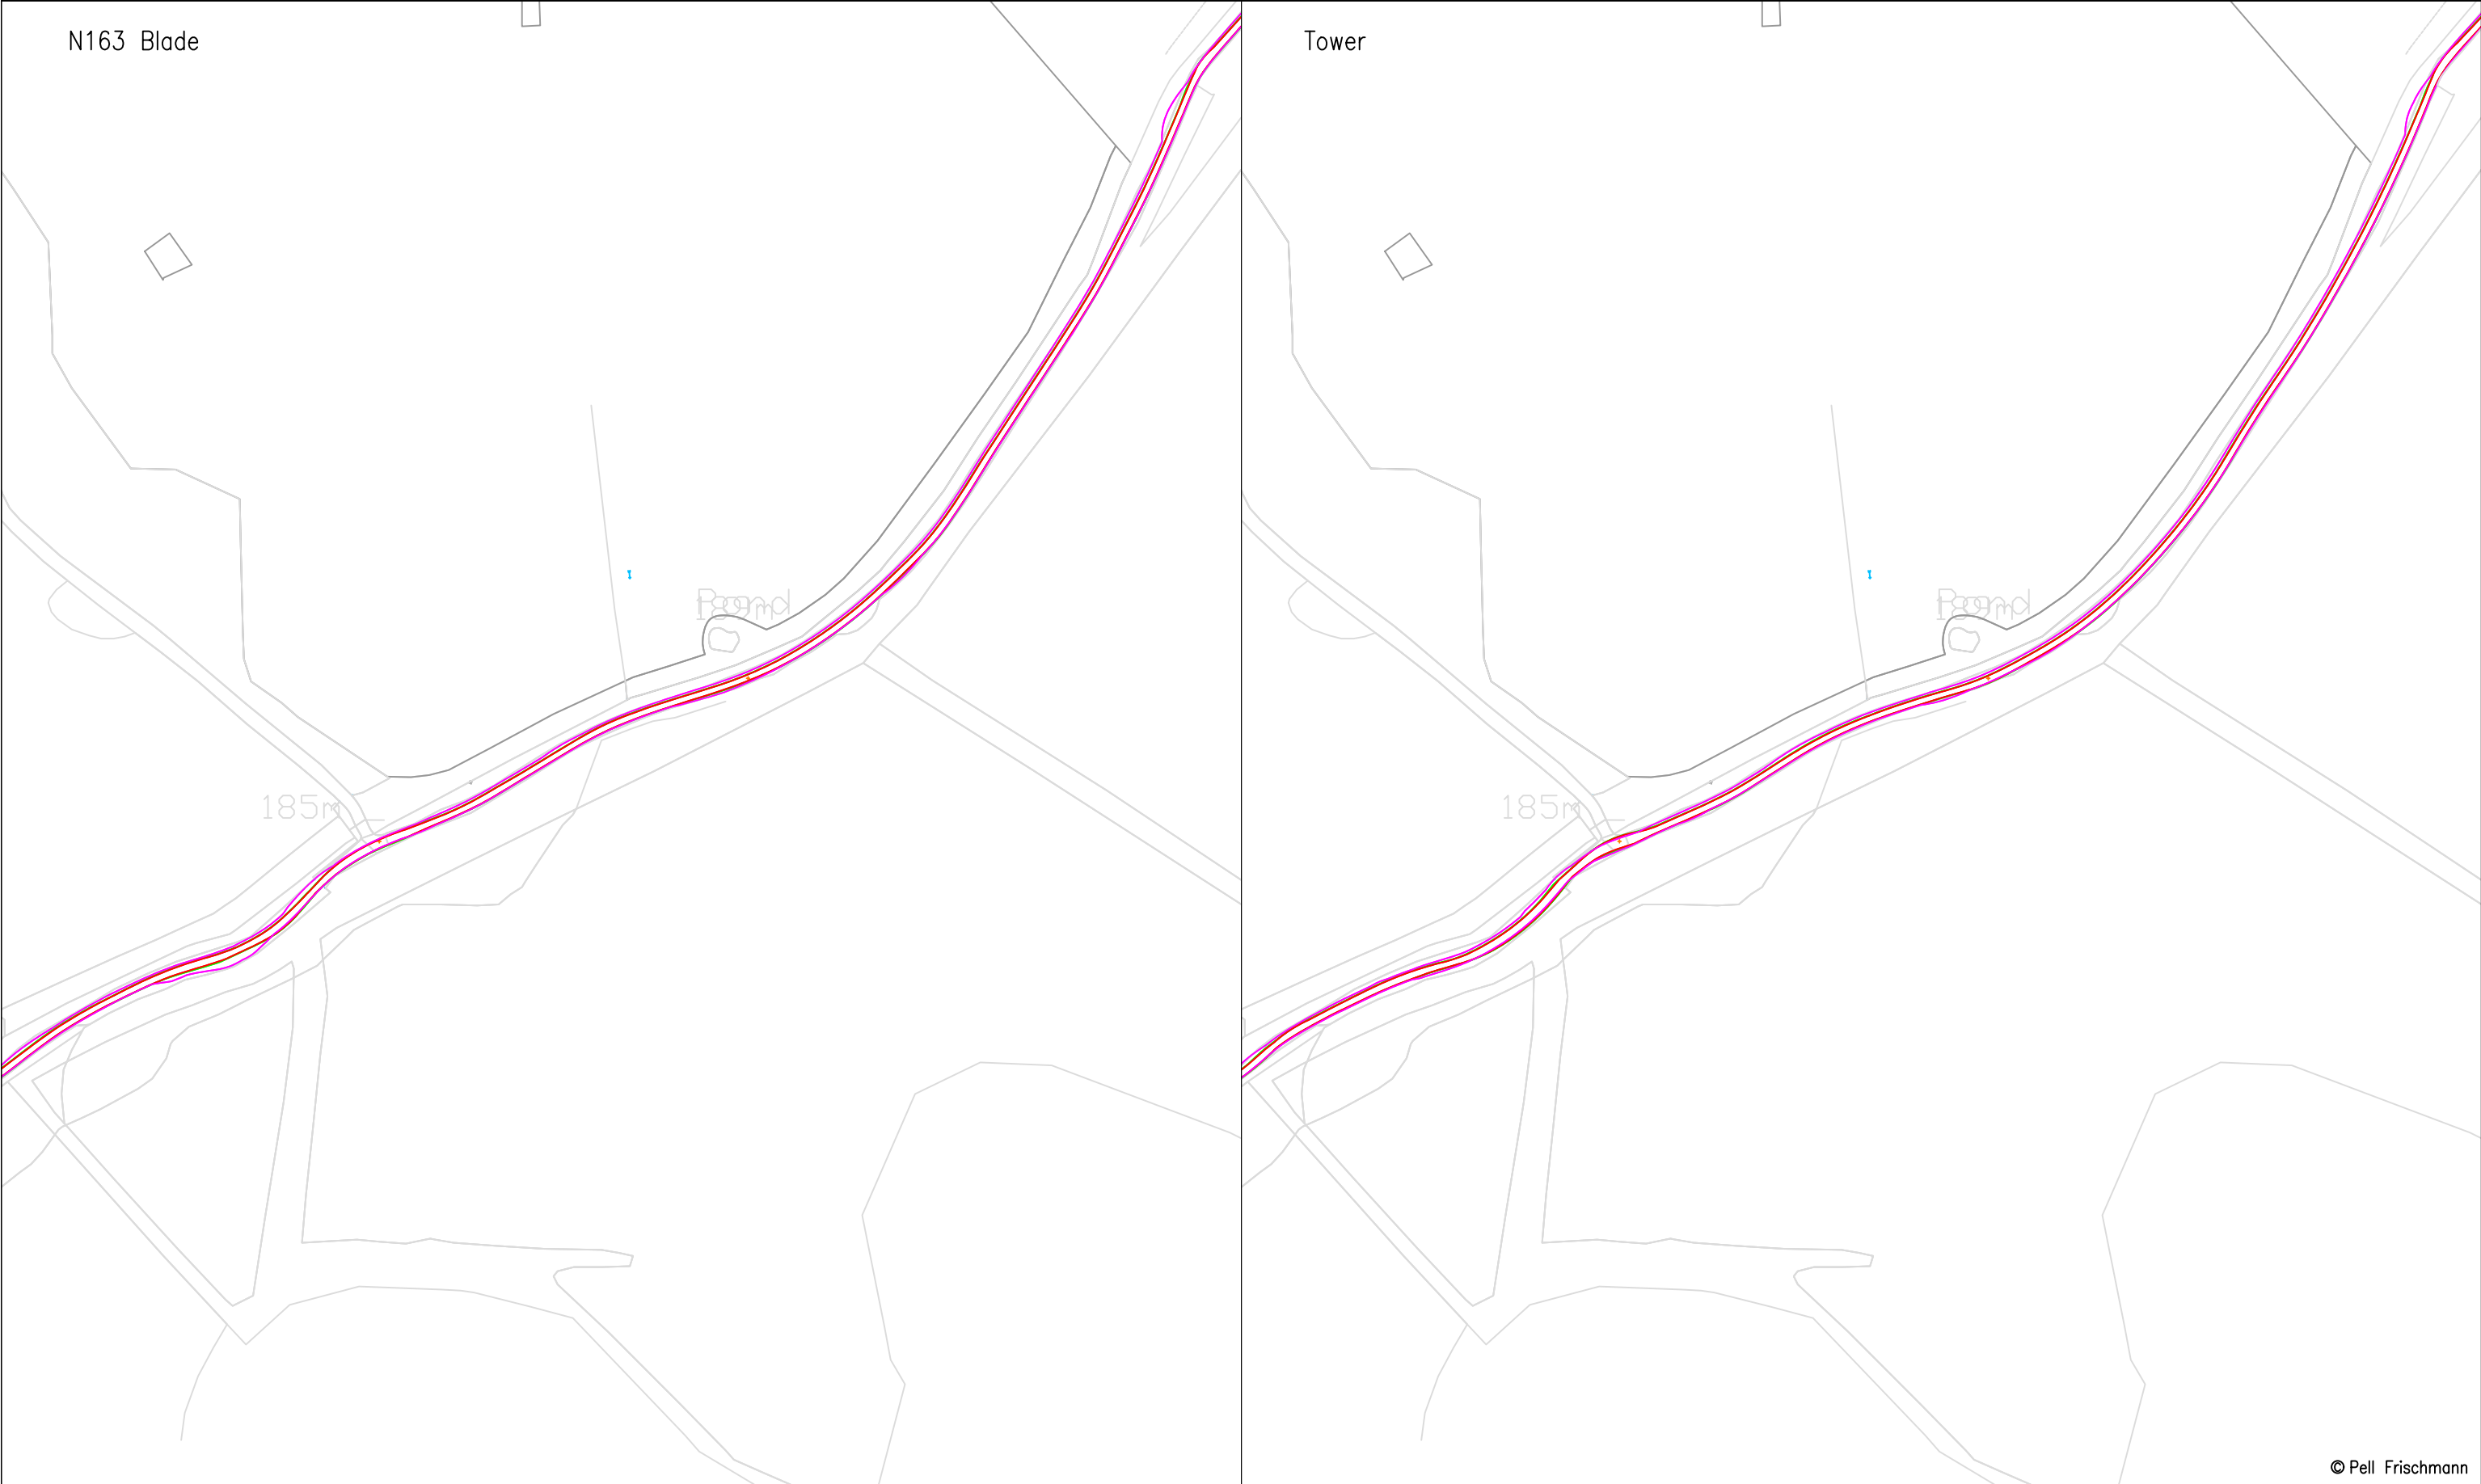


© Pell Frischmann

Pell Frischmann 93 GEORGE STREET, EDINBURGH, EH2 3ES Tel: +44 (0)131 240 1270 Email: pfedinburgh@pellfrischmann.com www.pellfrischmann.com	Project Appin Wind Farm			Name	Date	Scale 1:1500 @ A3	
			Drawn	GLJ	15/07/2022	20620 - Appin Tracking [SG155 N163 SG170]_Part2	
			Designed	GLJ	15/07/2022	Final.dwg	
			Checked	GB	15/07/2022	Drawing Status	
Client Statkraft	Drawing Title SG155 / N163 / SG170 Blades & 29.977 x 4.8 x 4.793 Tower		Point of Interest		86,87,88,89	Draft	
			Drawing No. SK54B		Notes: 1. All mitigation is subject to confirmation through a test run. 2. This is not a construction drawing and is intended for illustration purposes only.		
Key Wheel SPA Body SPA Load SPA Indicative Over-run Over-sail	SPA Location B729 Bends at Muirdrochwood				Revision 1		

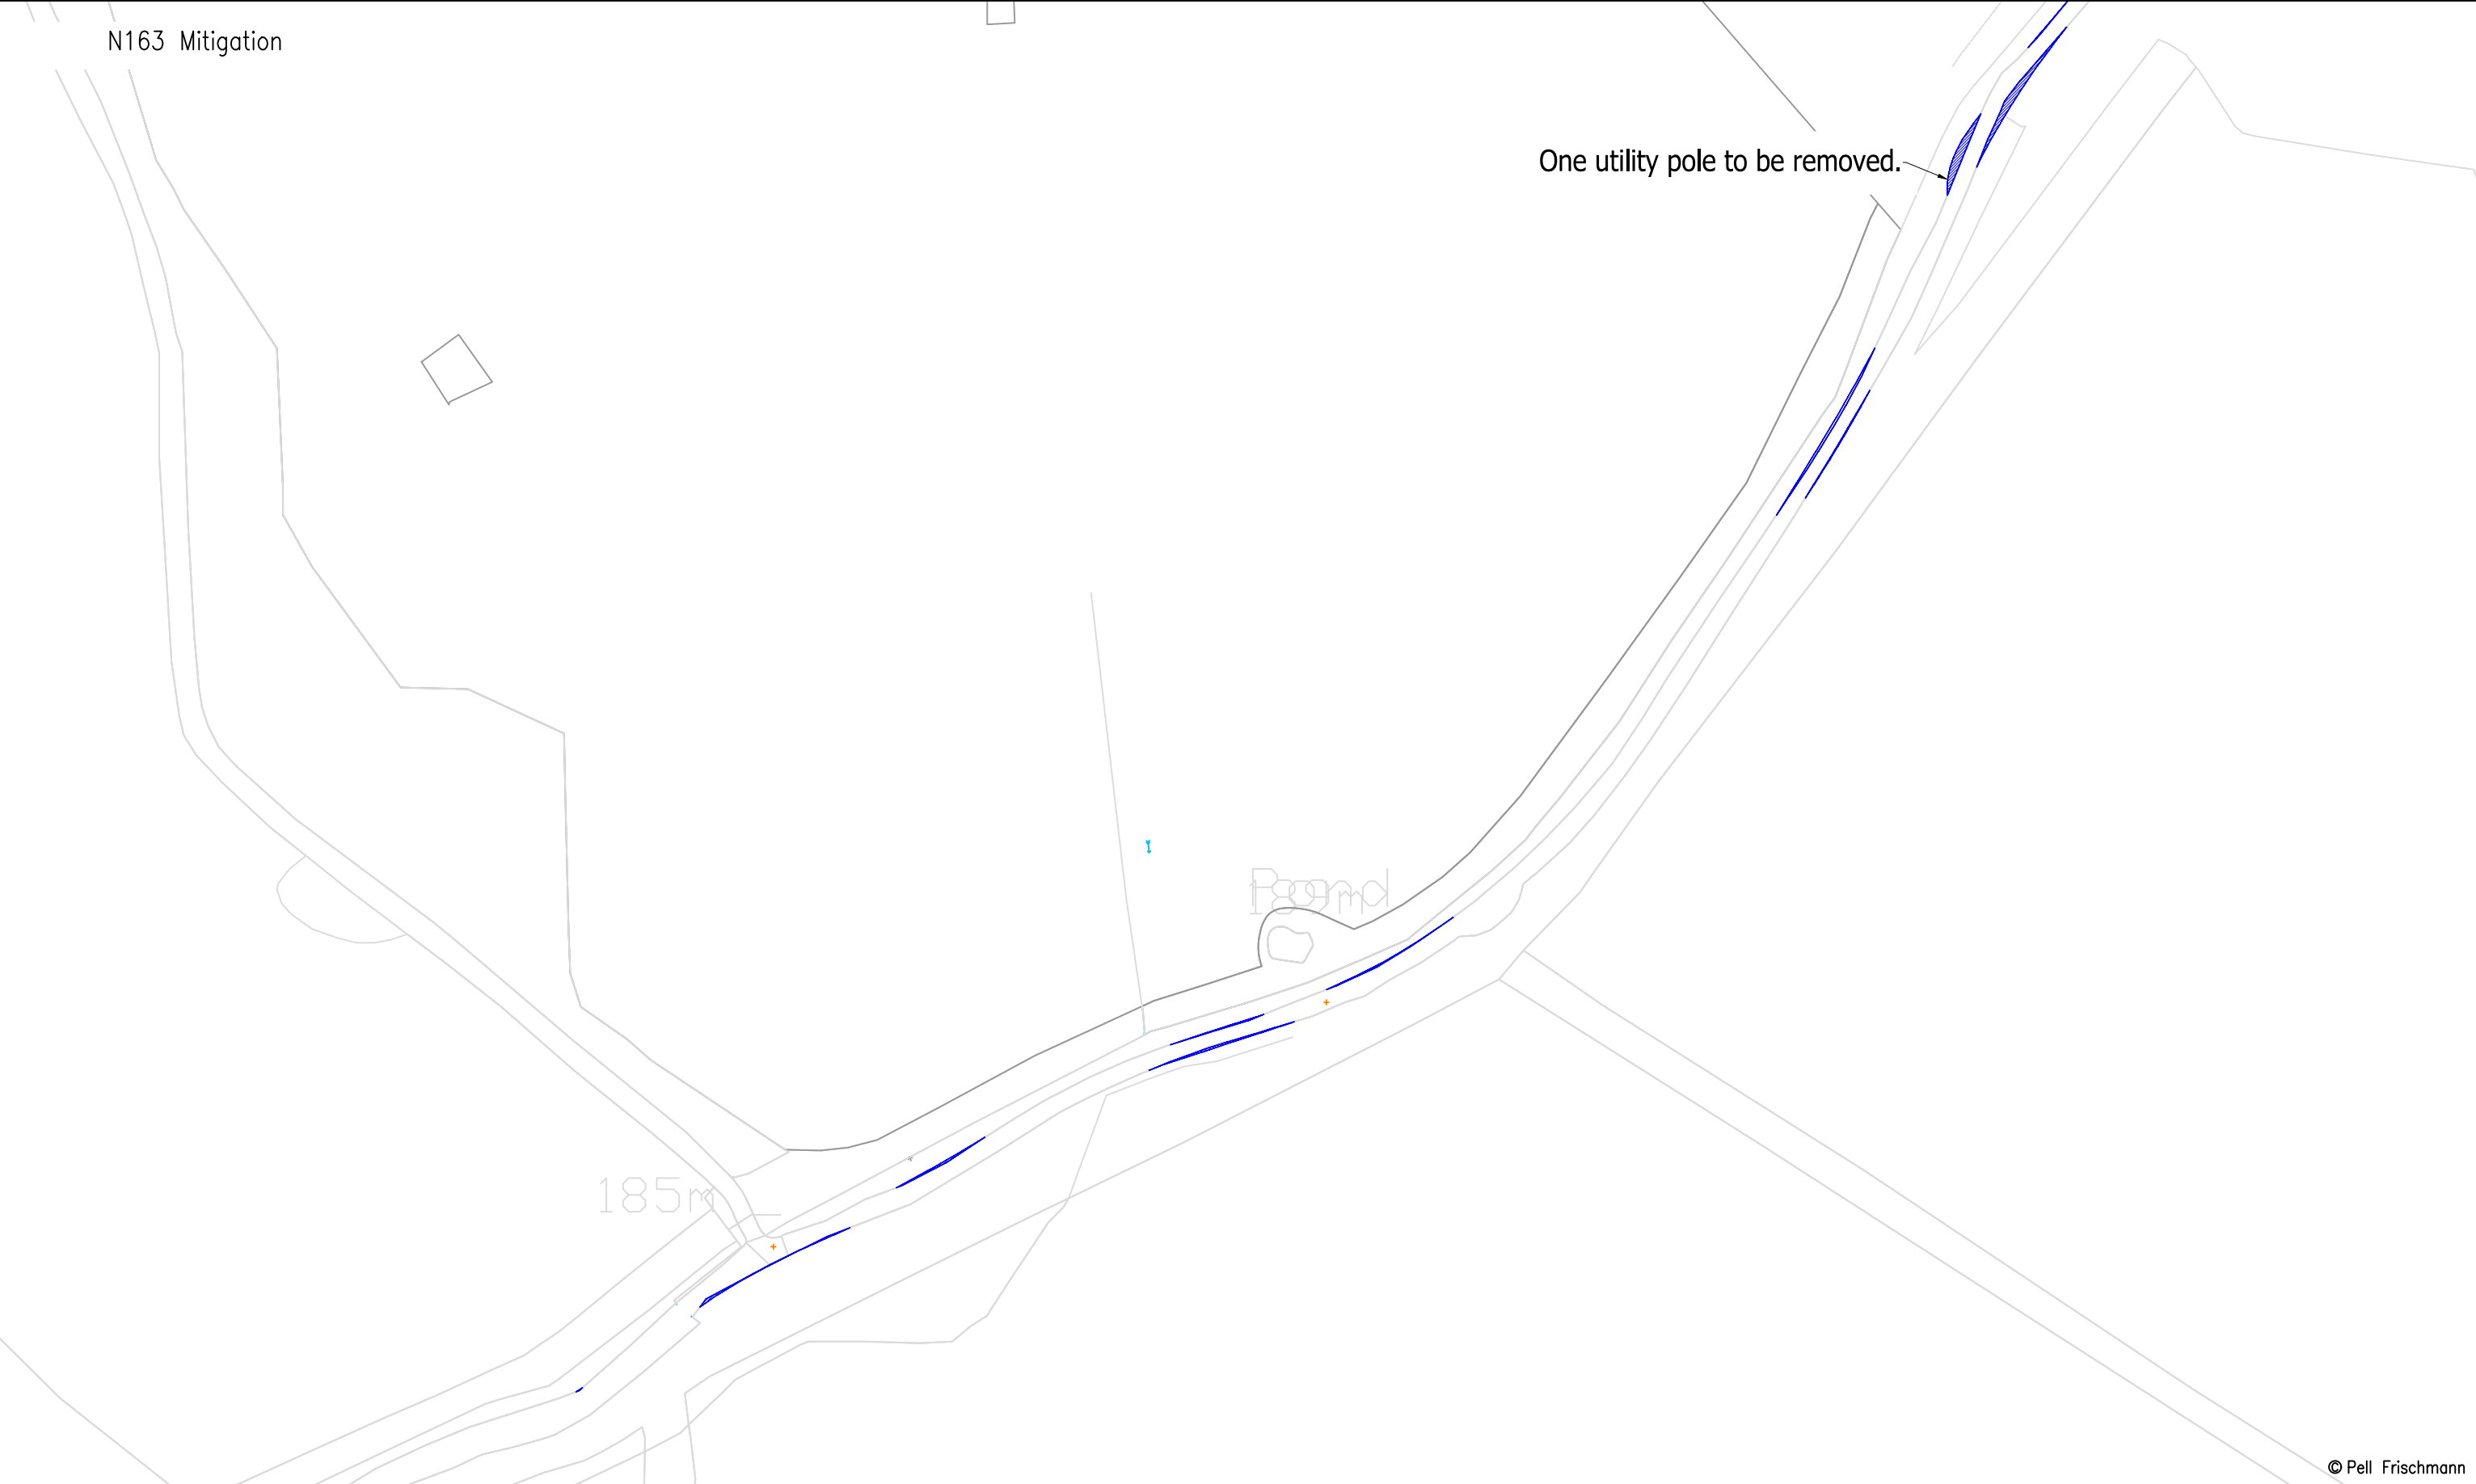

© Pell Frischmann

Pell Frischmann 93 GEORGE STREET, EDINBURGH, EH2 3ES Tel: +44 (0)131 240 1270 Email: pfedinburgh@pellfrischmann.com www.pellfrischmann.com	Project		Appin Wind Farm			Name	Date	Scale			
					Drawn	GLJ	15/07/2022	1:1500 @ A3			
					Designed	GLJ	15/07/2022	220622 - Appin Tracking [SG155 N163 SG170]_Part2			
					Checked	GB	15/07/2022	Final.dwg			
Client	Statkraft		Drawing Title		Point of Interest		86,87,88,89		Drawing Status		
									Draft		
Key	SPA Location		SG155 / N163 / SG170 Blades & 29.977 x 4.8 x 4.793 Tower		Drawing No.		Notes:		Revision		
											SK54C
								1. All mitigation is subject to confirmation through a test run.		1	
								2. This is not a construction drawing and is intended for illustration purposes only.			
Wheel SPA		Body SPA		Load SPA		Indicative		Over-run		Over-sail	

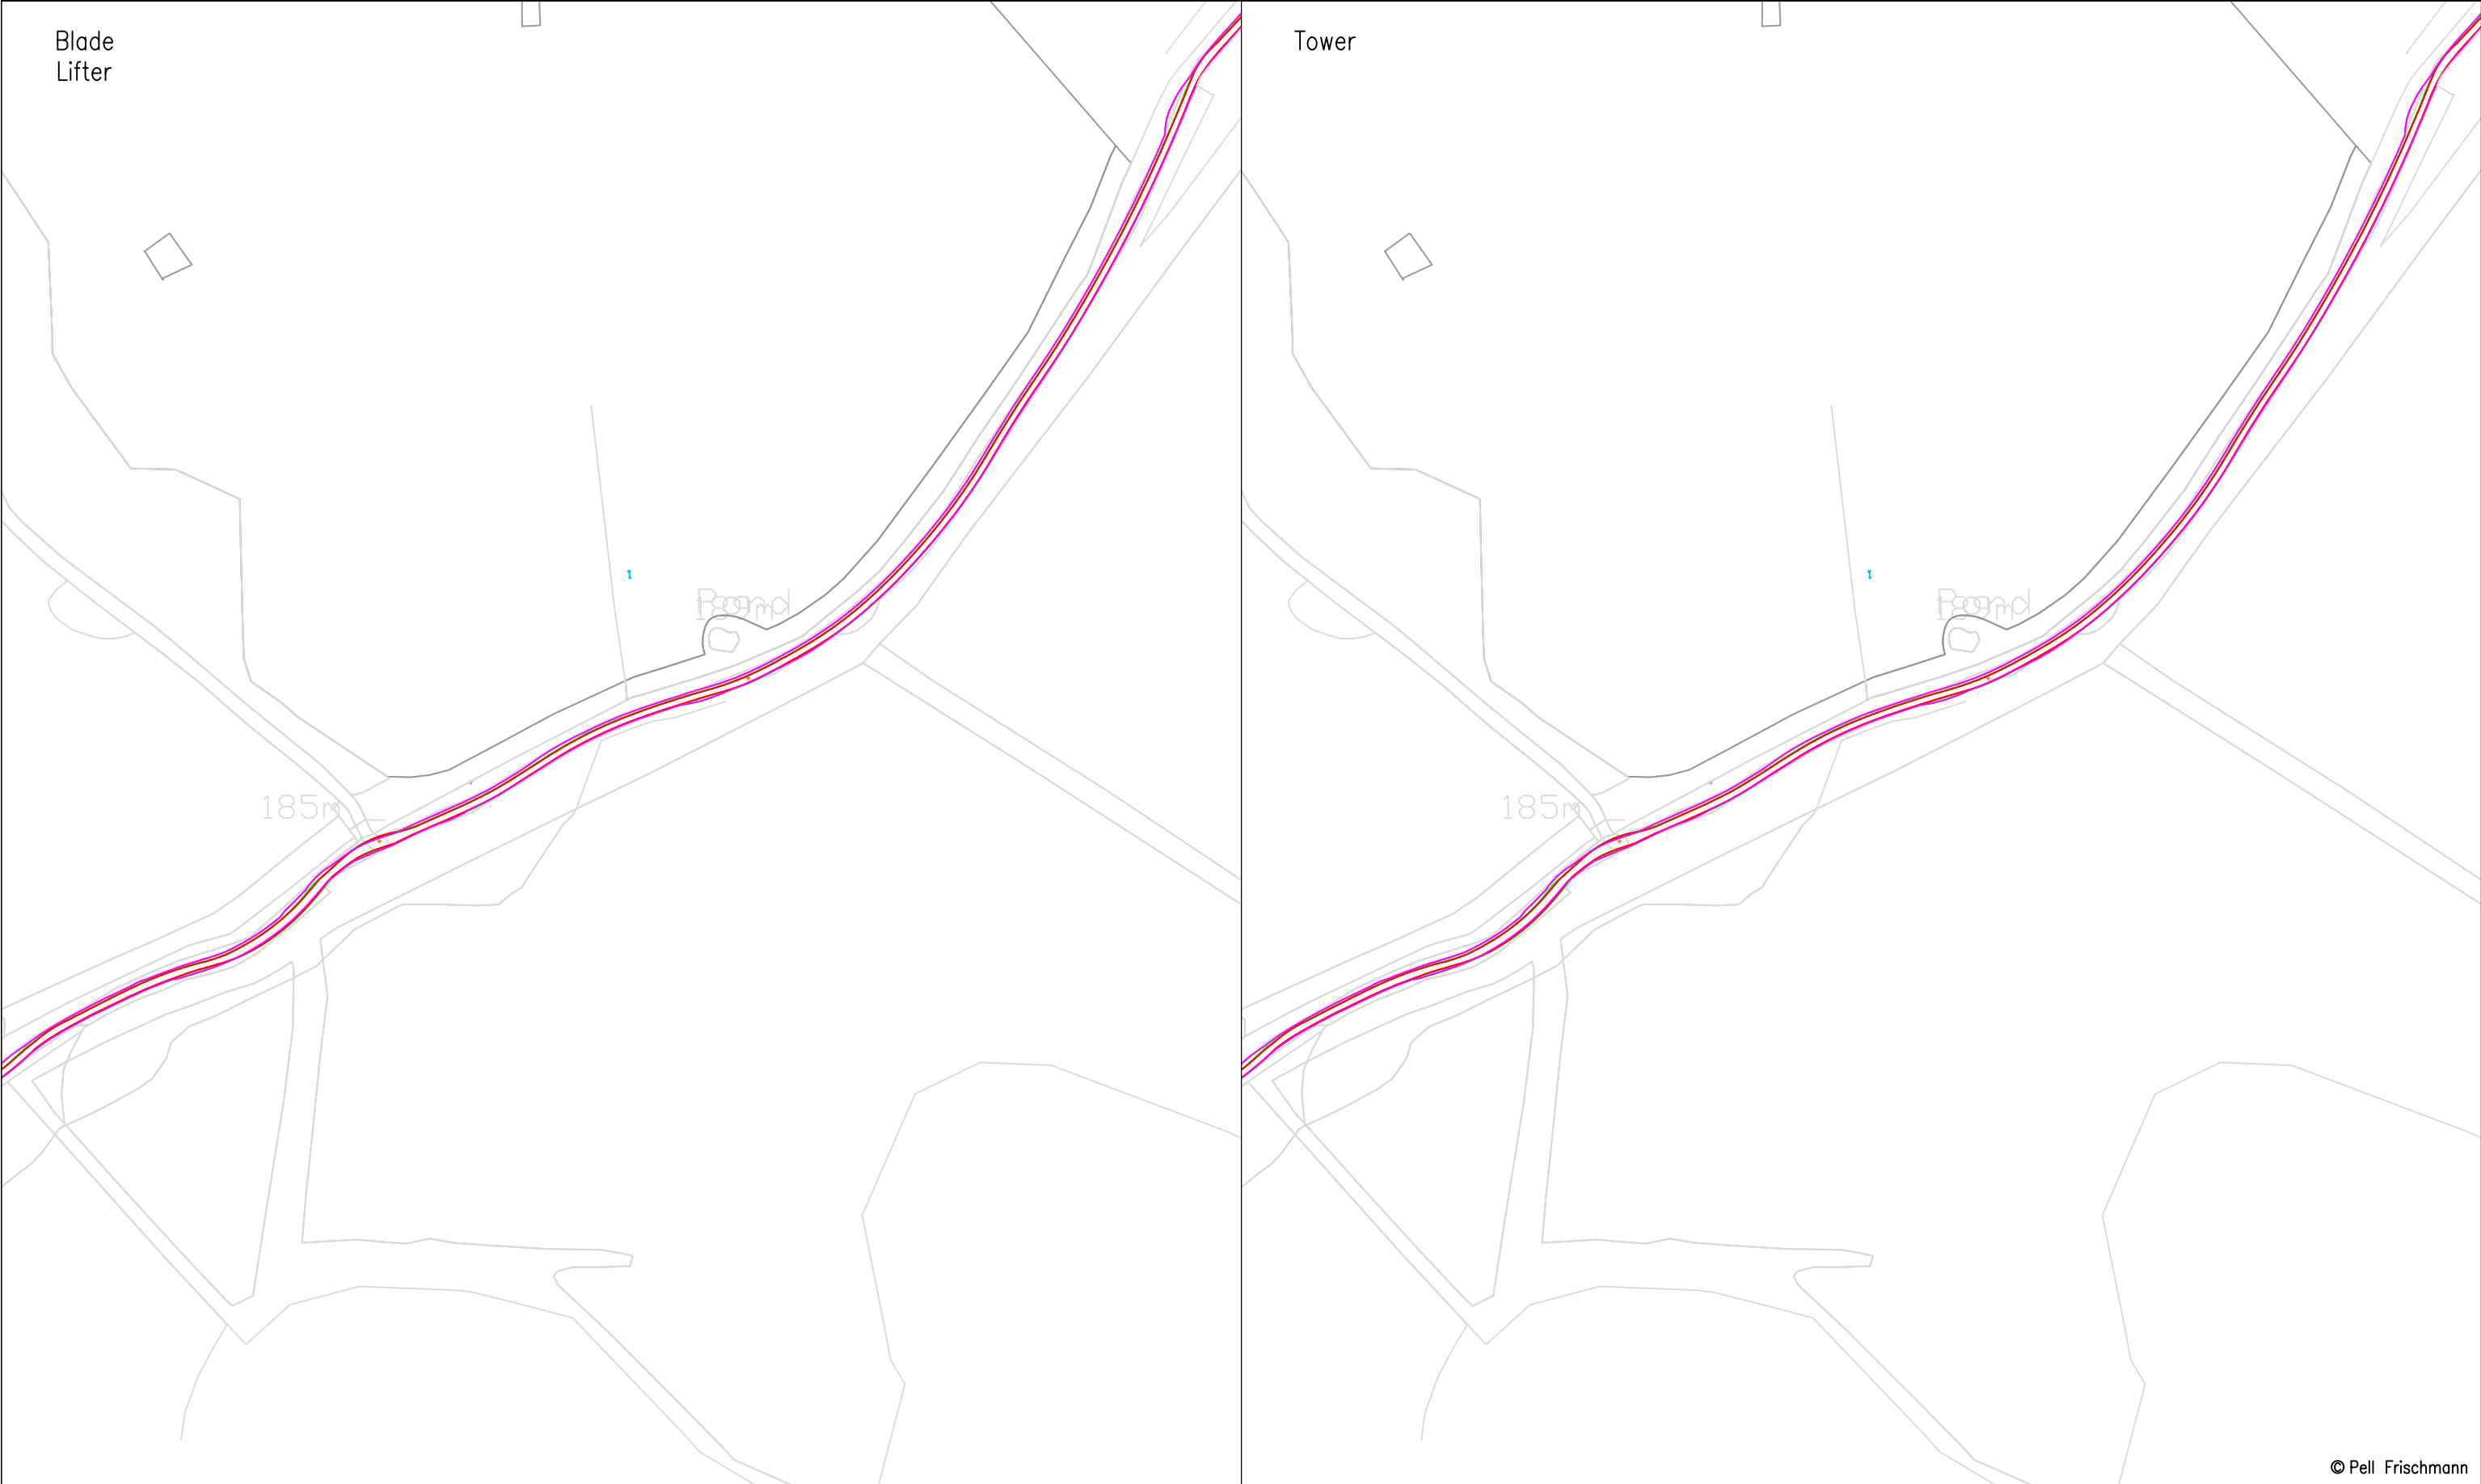

© Pell Frischmann

Pell Frischmann 93 GEORGE STREET, EDINBURGH, EH2 3ES Tel: +44 (0) 131 240 1270 Email: pfedinburgh@pellfrischmann.com www.pellfrischmann.com	Project		Appin Wind Farm			Name	Date	Scale	
					Drawn	GLJ	15/07/2022	1:1500 @ A3	
					Designed	GLJ	15/07/2022	220622 - Appin Tracking [SG155 N163 SG170]_Part2	
					Checked	GB	15/07/2022	Final.dwg	
Client Statkraft	Drawing Title		SG155 / N163 / SG170 Blades & 29.977 x 4.8 x 4.793 Tower		Point of Interest		86,87,88,89		Drawing Status
	SPA Location		B729 Bends at Muirdrochwood		Drawing No.		SK54D		Revision
					Notes:		1. All mitigation is subject to confirmation through a test run. 2. This is not a construction drawing and is intended for illustration purposes only.		1

Key

Wheel SPA

Body SPA

Load SPA

Indicative

Over-run

Over-sail



Pell Frischmann 93 GEORGE STREET, EDINBURGH, EH2 3ES Tel: +44 (0)131 240 1270 Email: p.fedinburgh@pellfrischmann.com www.pellfrischmann.com	Project	Appin Wind Farm			Name	Date	Scale		
				Drawn	GLJ	15/07/2022	1:1500 @ A3		
				Designed	GLJ	15/07/2022	20612 - Appin Tracking [SG155 N163 SG170]_Part2		
				Checked	GB	15/07/2022	Final.dwg		
Client	Statkraft	Drawing Title	SG155 / N163 / SG170 Blades & 29.977 x 4.8 x 4.793 Tower		Point of Interest		86,87,88,89	Drawing Status	
					Draft				
Key		SPA Location	B729 Marscloch Bends		Drawing No.	SK54E	Notes:		Revision
							1. All mitigation is subject to confirmation through a test run. 2. This is not a construction drawing and is intended for illustration purposes only.		
									1


SG155 Blade

Tower



© Pell Frischmann


Pell Frischmann 93 GEORGE STREET, EDINBURGH, EH2 3ES Tel: +44 (0)131 240 1270 Email: p.fedinburgh@pellfrischmann.com www.pellfrischmann.com	Project		Appin Wind Farm			Name	Date	Scale			
					Drawn	GLJ	15/07/2022	1:500 @ A3			
					Designed	GLJ	15/07/2022	20620 - Appin Tracking [SG155 N163 SG170]_Part2			
					Checked	GB	15/07/2022	Final.dwg			
Client	Statkraft		Drawing Title		Point of Interest		90		Drawing Status		
									Draft		
Key	SPA Location		SG155 / N163 / SG170 Blades & 29.977 x 4.8 x 4.793 Tower		Drawing No.		Notes:		Revision		
											SK55
Wheel SPA		Body SPA		Load SPA		Indicative		Over-run		Over-sail	
				B729 / Water o Ken Junction				1. All mitigation is subject to confirmation through a test run. 2. This is not a construction drawing and is intended for illustration purposes only.		1	

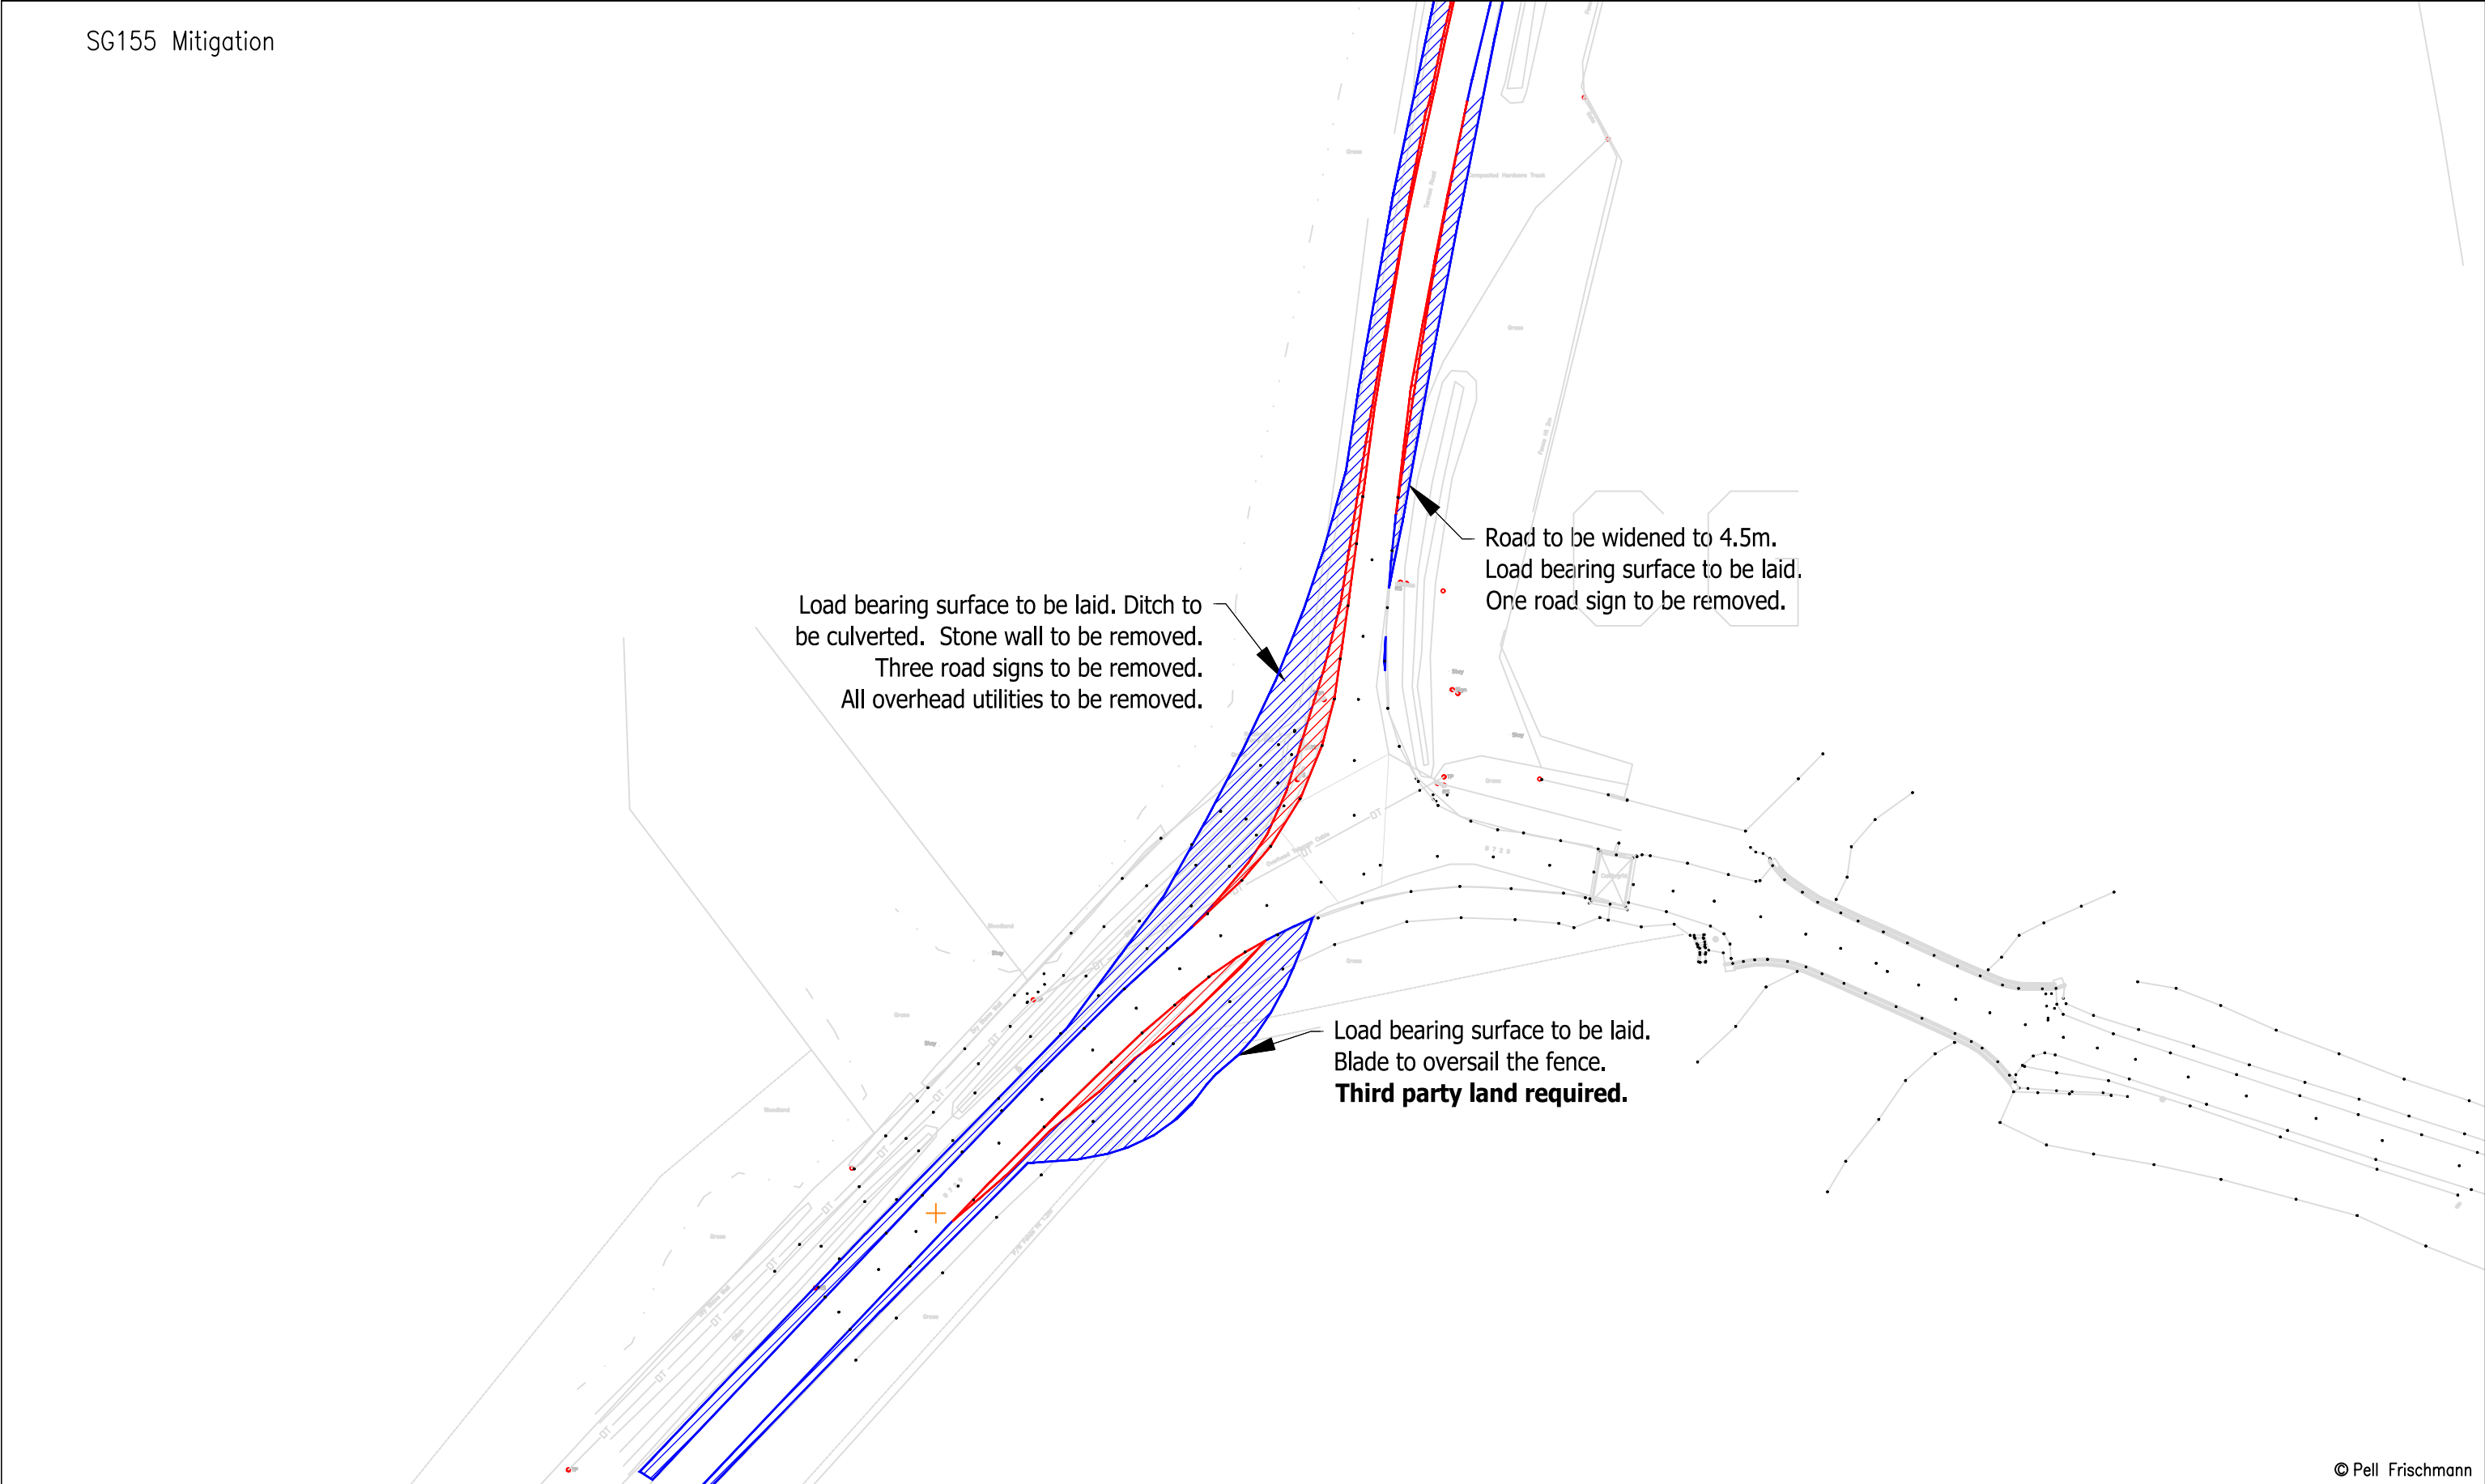

© Pell Frischmann


Pell Frischmann 93 GEORGE STREET, EDINBURGH, EH2 3ES Tel: +44 (0)131 240 1270 Email: p.fedinburgh@pellfrischmann.com www.pellfrischmann.com	Project	Appin Wind Farm			Name	Date	Scale		
				Drawn	GLJ	15/07/2022	1:500 @ A3		
				Designed	GLJ	15/07/2022	20620 - Appin Tracking [SG155 N163 SG170]_Part2		
				Checked	GB	15/07/2022	Final.dwg		
Client	Statkraft	Drawing Title	SG155 / N163 / SG170 Blades & 29.977 x 4.8 x 4.793 Tower		Point of Interest		90	Drawing Status	
					Draft				
Key	Wheel SPA Body SPA Load SPA Indicative	SPA Location	B729 / Water o Ken Junction		Drawing No.	SK55A	Notes:		Revision
							1. All mitigation is subject to confirmation through a test run. 2. This is not a construction drawing and is intended for illustration purposes only.		
								1	

Pell Frischmann 93 GEORGE STREET, EDINBURGH, EH2 3ES Tel: +44 (0)131 240 1270 Email: pfredinburgh@pellfrischmann.com www.pellfrischmann.com	Project	Appin Wind Farm			Name	Date	Scale		1:500 @ A3		
		Drawn	GLJ	15/07/2022	210622-Appin Tracking [SG155 N163 SG170]_Part2						
		Designed	GLJ	15/07/2022	Final.dwg						
		Checked	GB	15/07/2022	Drawing Status		Draft				
Client	Statkraft	Drawing Title		SG155 / N163 / SG170 Blades & 29.977 x 4.8 x 4.793 Tower		Point of Interest		90			
Key		SPA Location		B729 / Water o Ken Junction		Drawing No.		Notes:		Revision	
Wheel SPA Body SPA Load SPA Indicative Over-run Over-sail						SK55B	1. All mitigation is subject to confirmation through a test run. 2. This is not a construction drawing and is intended for illustration purposes only.				1

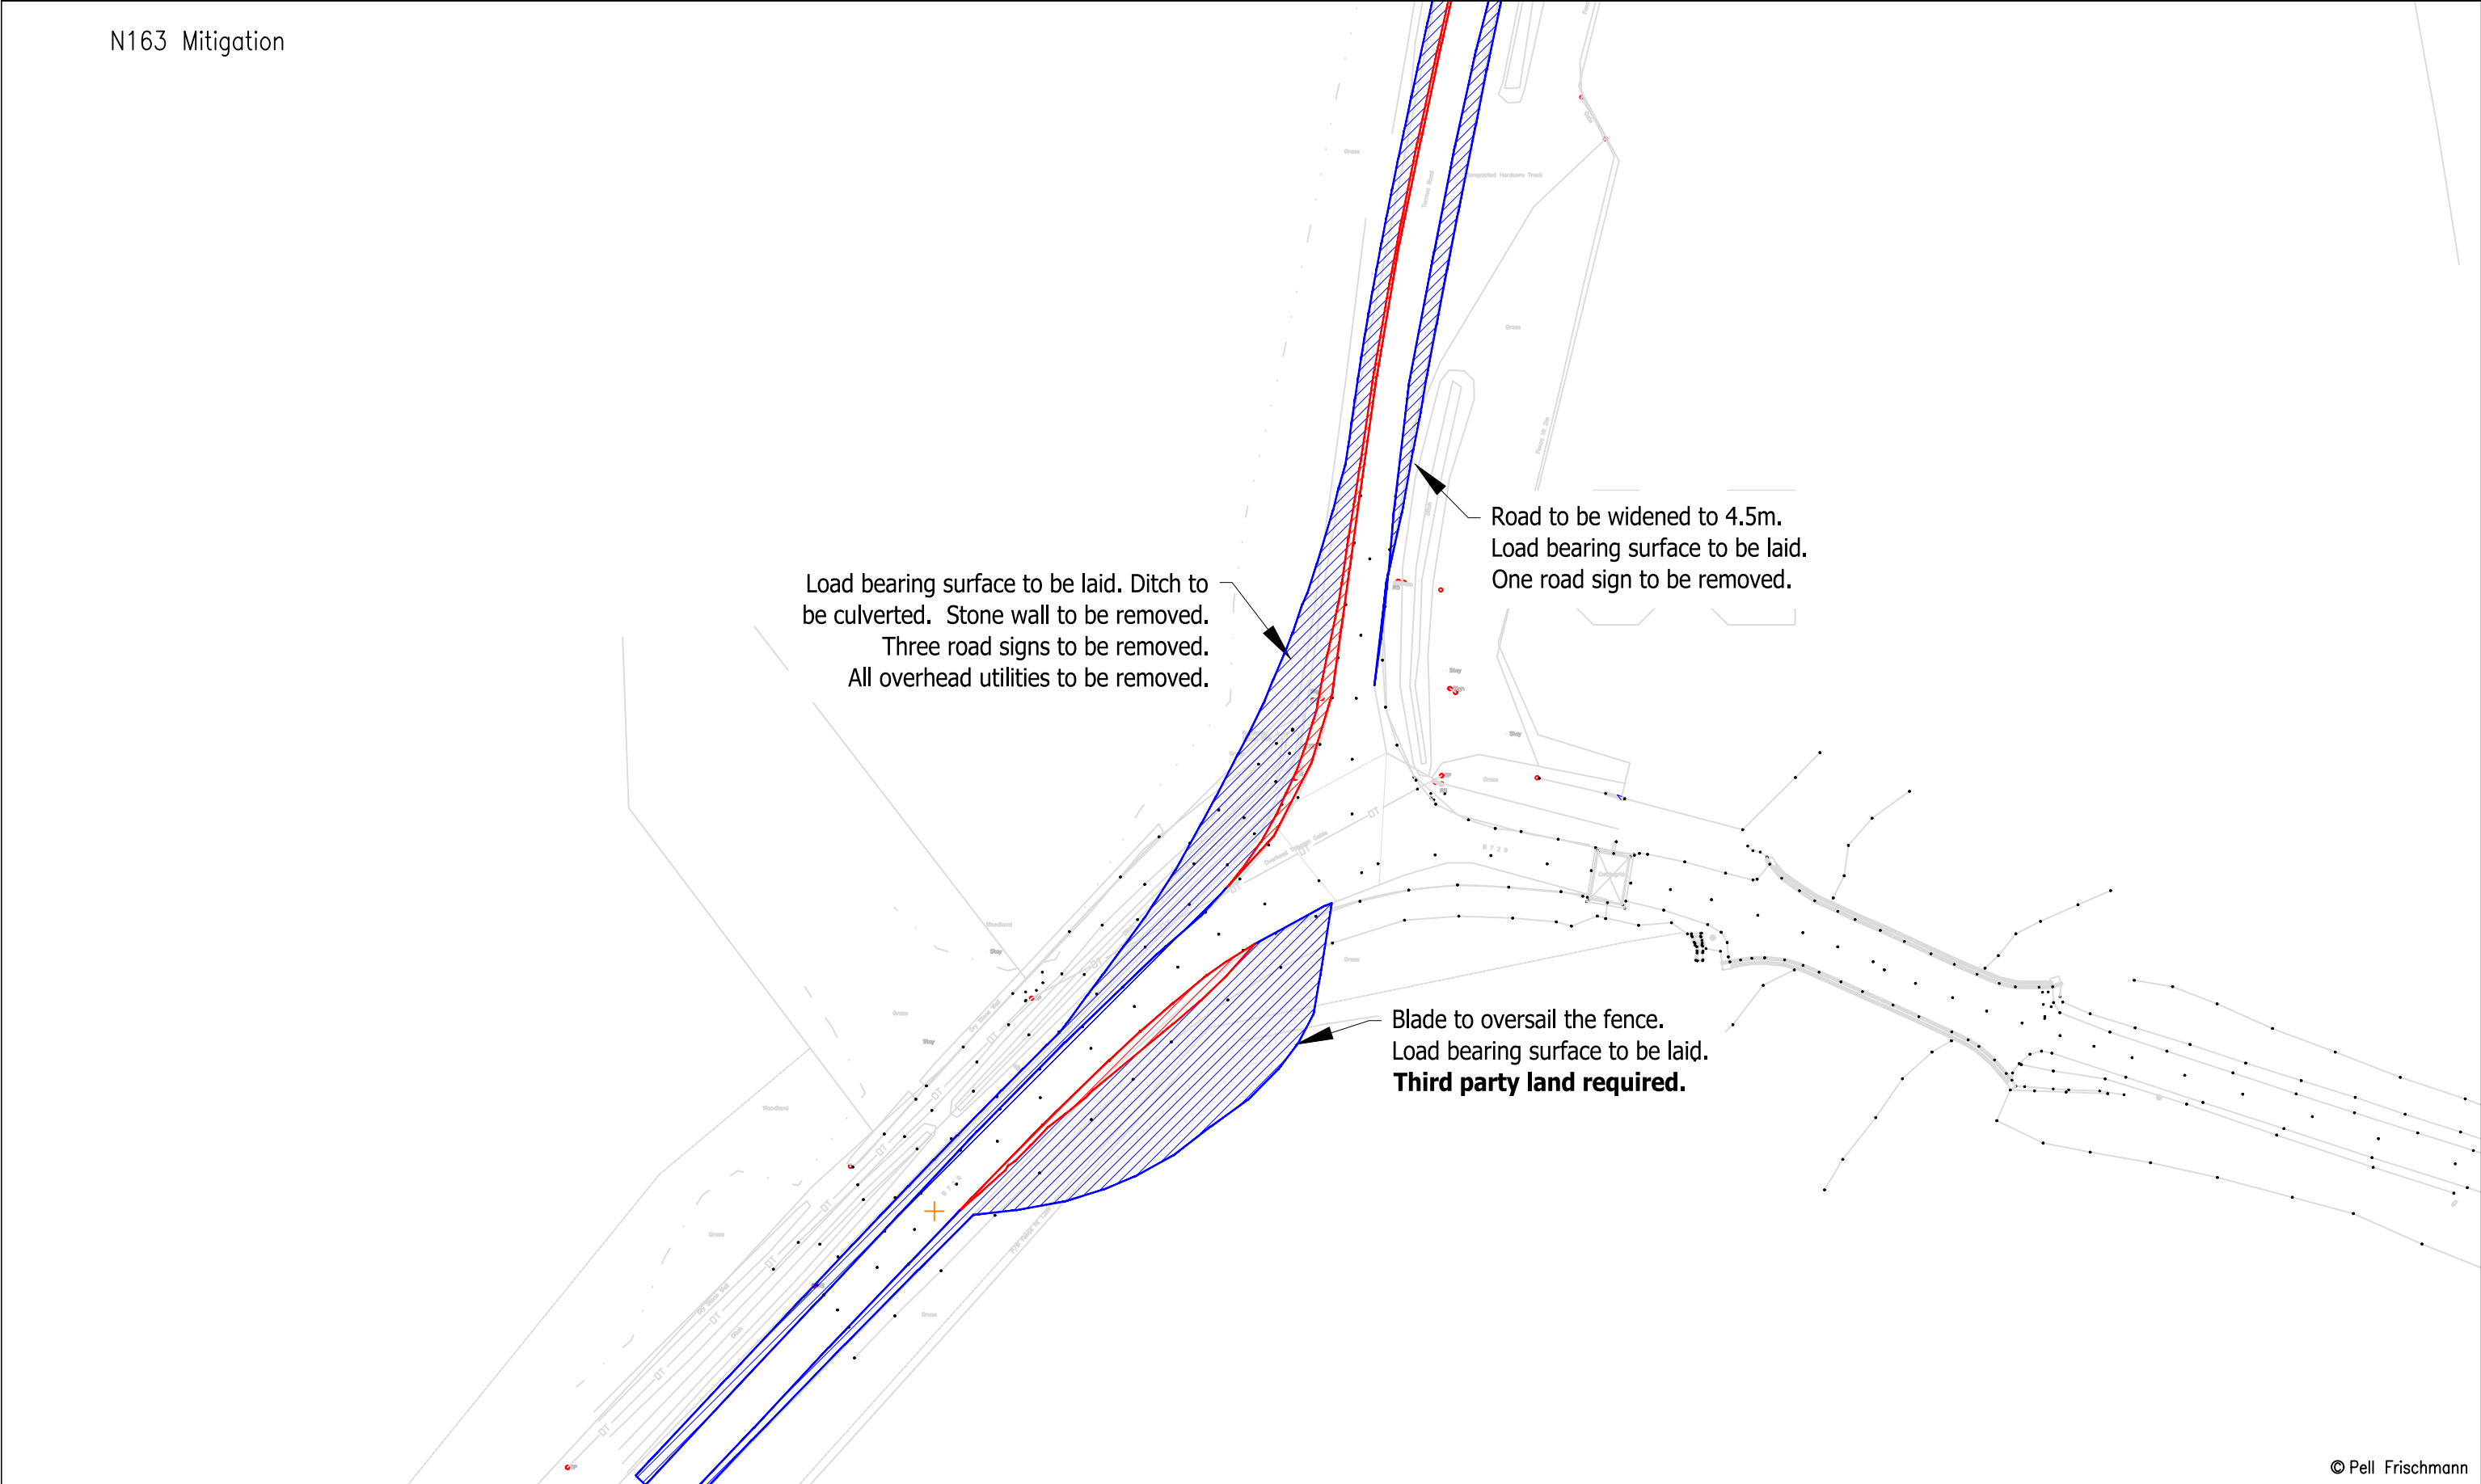


© Pell Frischmann

Pell Frischmann 93 GEORGE STREET, EDINBURGH, EH2 3ES Tel: +44 (0)131 240 1270 Email: pfedinburgh@pellfrischmann.com www.pellfrischmann.com	Project	Appin Wind Farm		Name	Date	Scale	
			Drawn	GLJ	15/07/2022	1:500 @ A3	
			Designed	GLJ	15/07/2022	220622 - Appin Tracking [SG155 N163 SG170]_Part2	
			Checked	GB	15/07/2022	Final.dwg	
Client	Drawing Title	SG155 / N163 / SG170 Blades & 29.977 x 4.8 x 4.793 Tower	Point of Interest		90	Drawing Status	
						Draft	
Key	SPA Location	B729 / Water o Ken Junction	Drawing No.	SK55C	Notes:		Revision
					1. All mitigation is subject to confirmation through a test run. 2. This is not a construction drawing and is intended for illustration purposes only.		
Wheel SPA	Body SPA						1
Load SPA	Indicative						
Over-run	Over-sail						

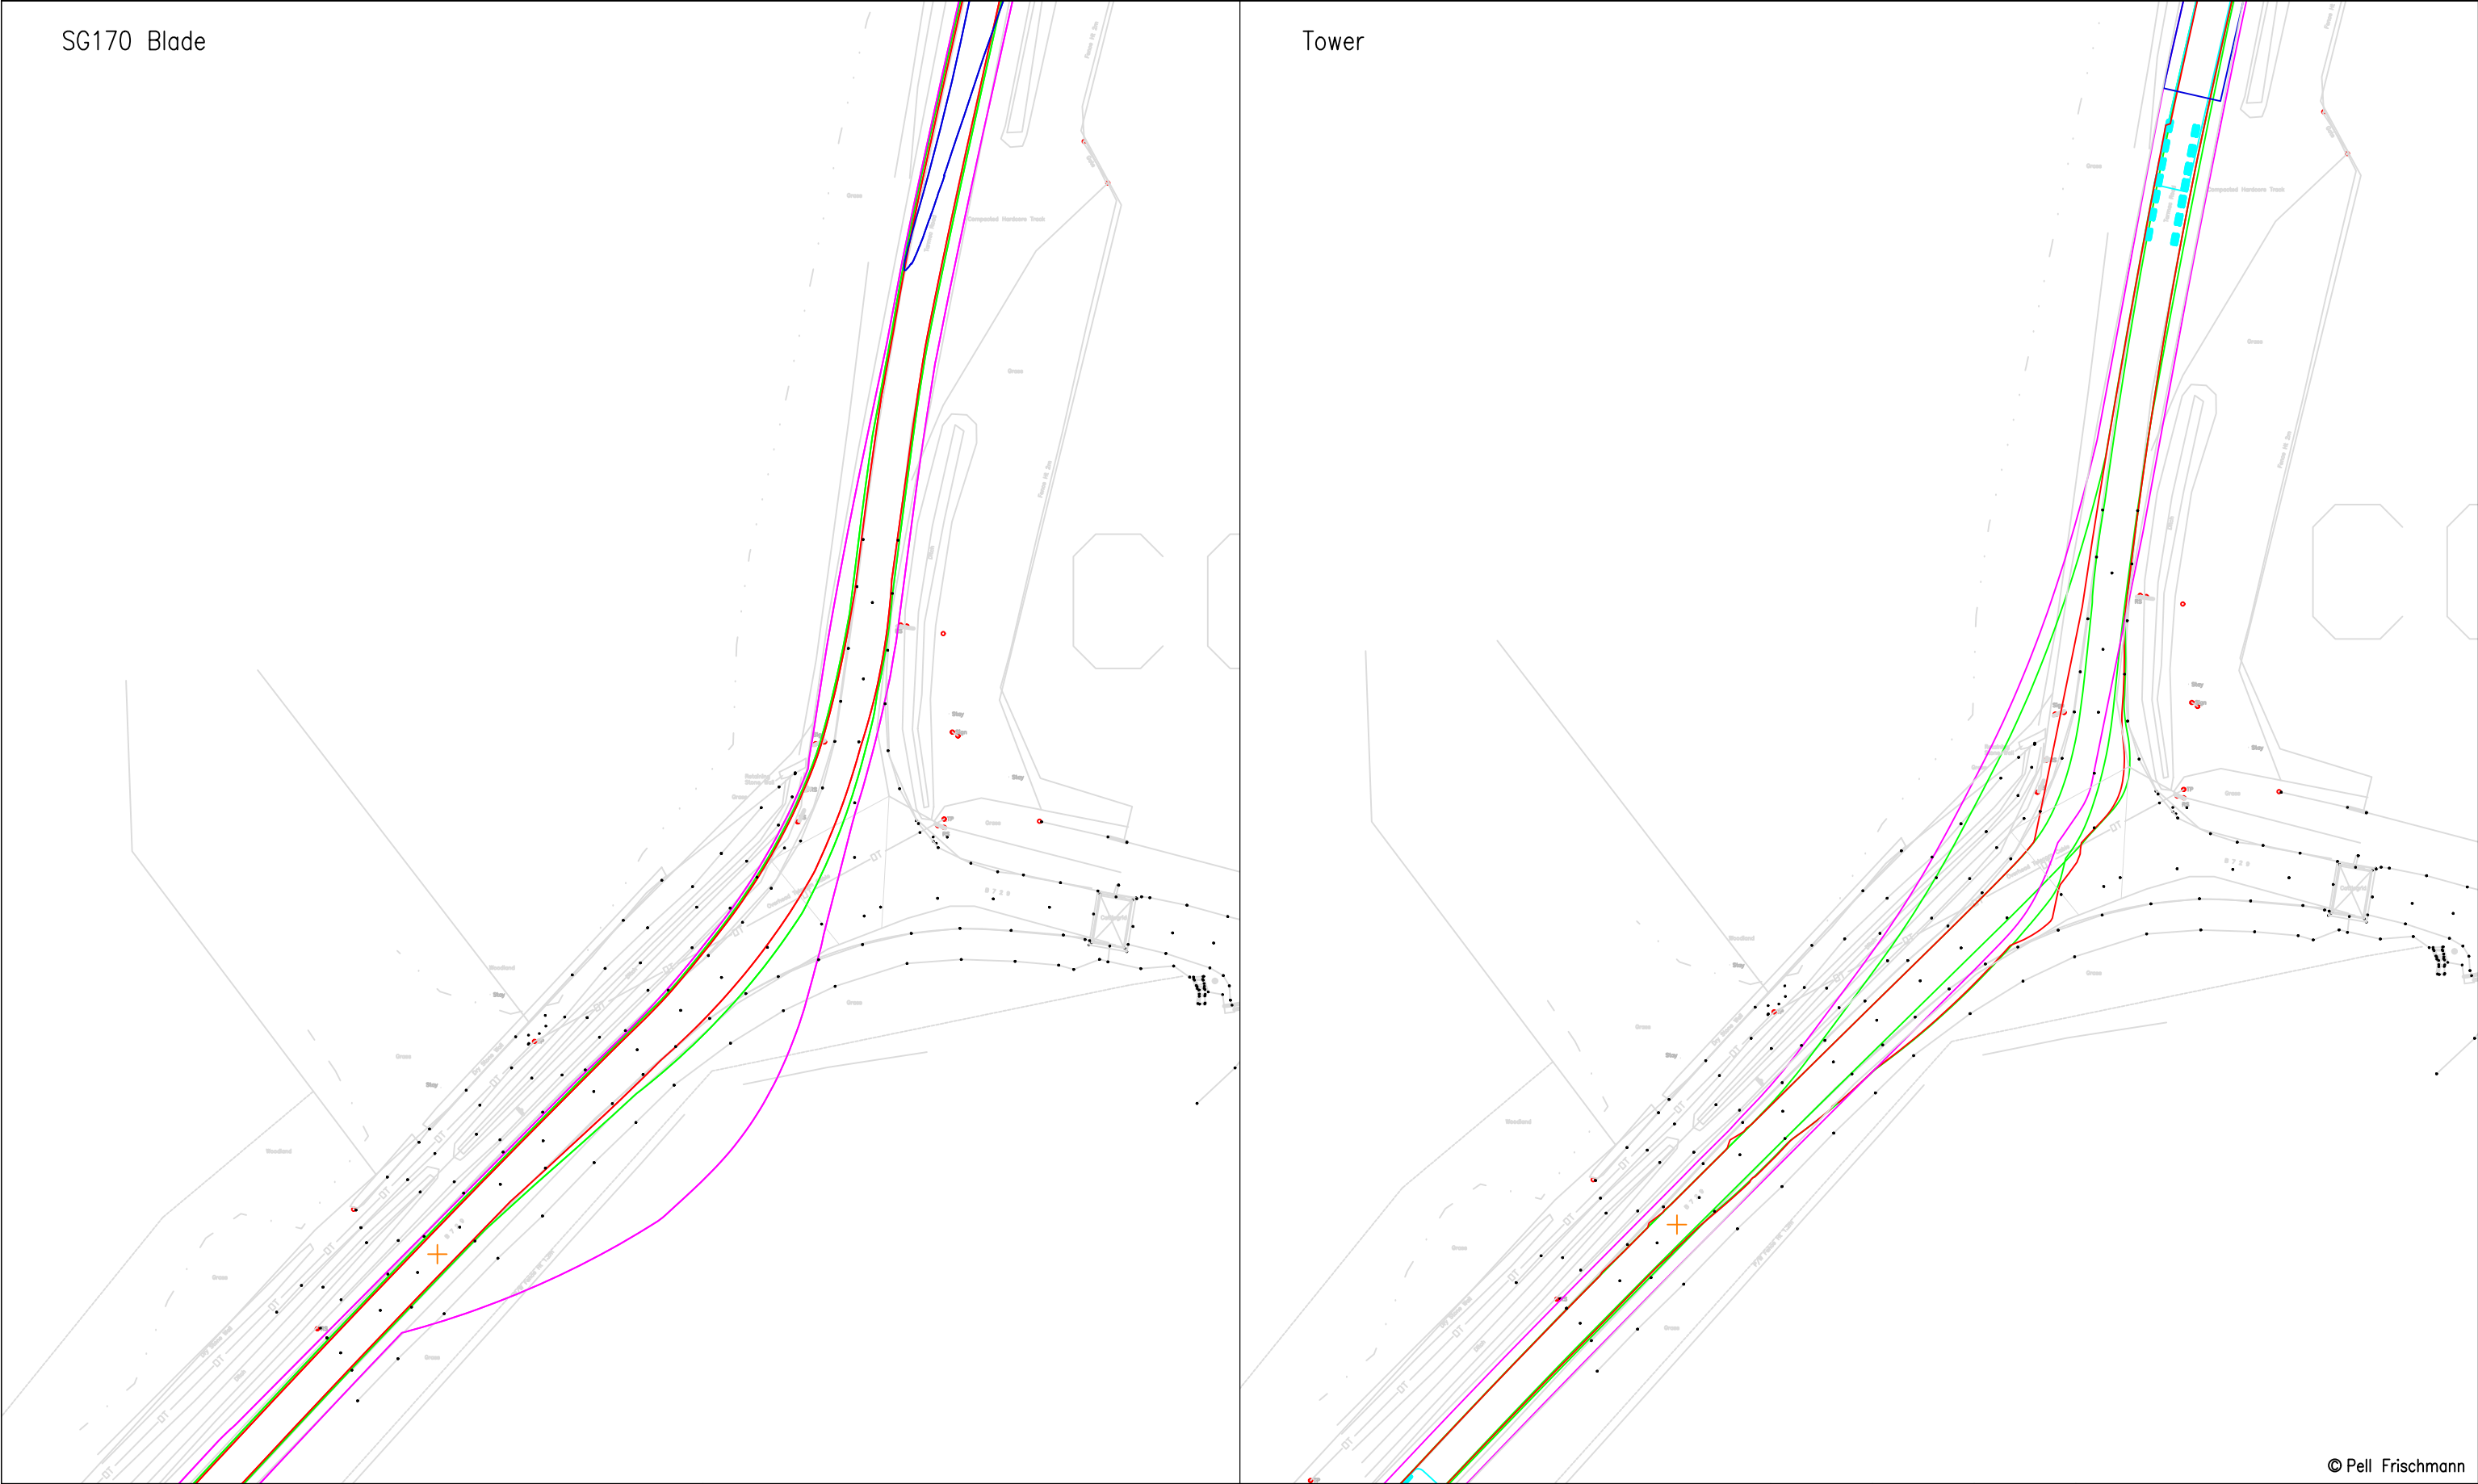

Pell Frischmann 93 GEORGE STREET, EDINBURGH, EH2 3ES Tel: +44 (0) 131 240 1270 Email: pfredinburgh@pellfrischmann.com www.pellfrischmann.com		Project		Name		Date	Scale	
		Appin Wind Farm		GLJ		15/07/2022	1:500 @ A3	
		Drawing Title		GLJ		15/07/2022	20620 - Appin Tracking [SG155 N163 SG170]_Part2	
		SPA Location		GB		15/07/2022	Final.dwg	
Client		Statkraft		Point of Interest		90	Drawing Status	
Key Wheel SPA Body SPA Load SPA Indicative Over-run Over-sail		SG155 / N163 / SG170 Blades & 29.977 x 4.8 x 4.793 Tower		Drawing No.		Notes:		Revision
		B729 / Water o Ken Junction		SK55D		1. All mitigation is subject to confirmation through a test run. 2. This is not a construction drawing and is intended for illustration purposes only.		1


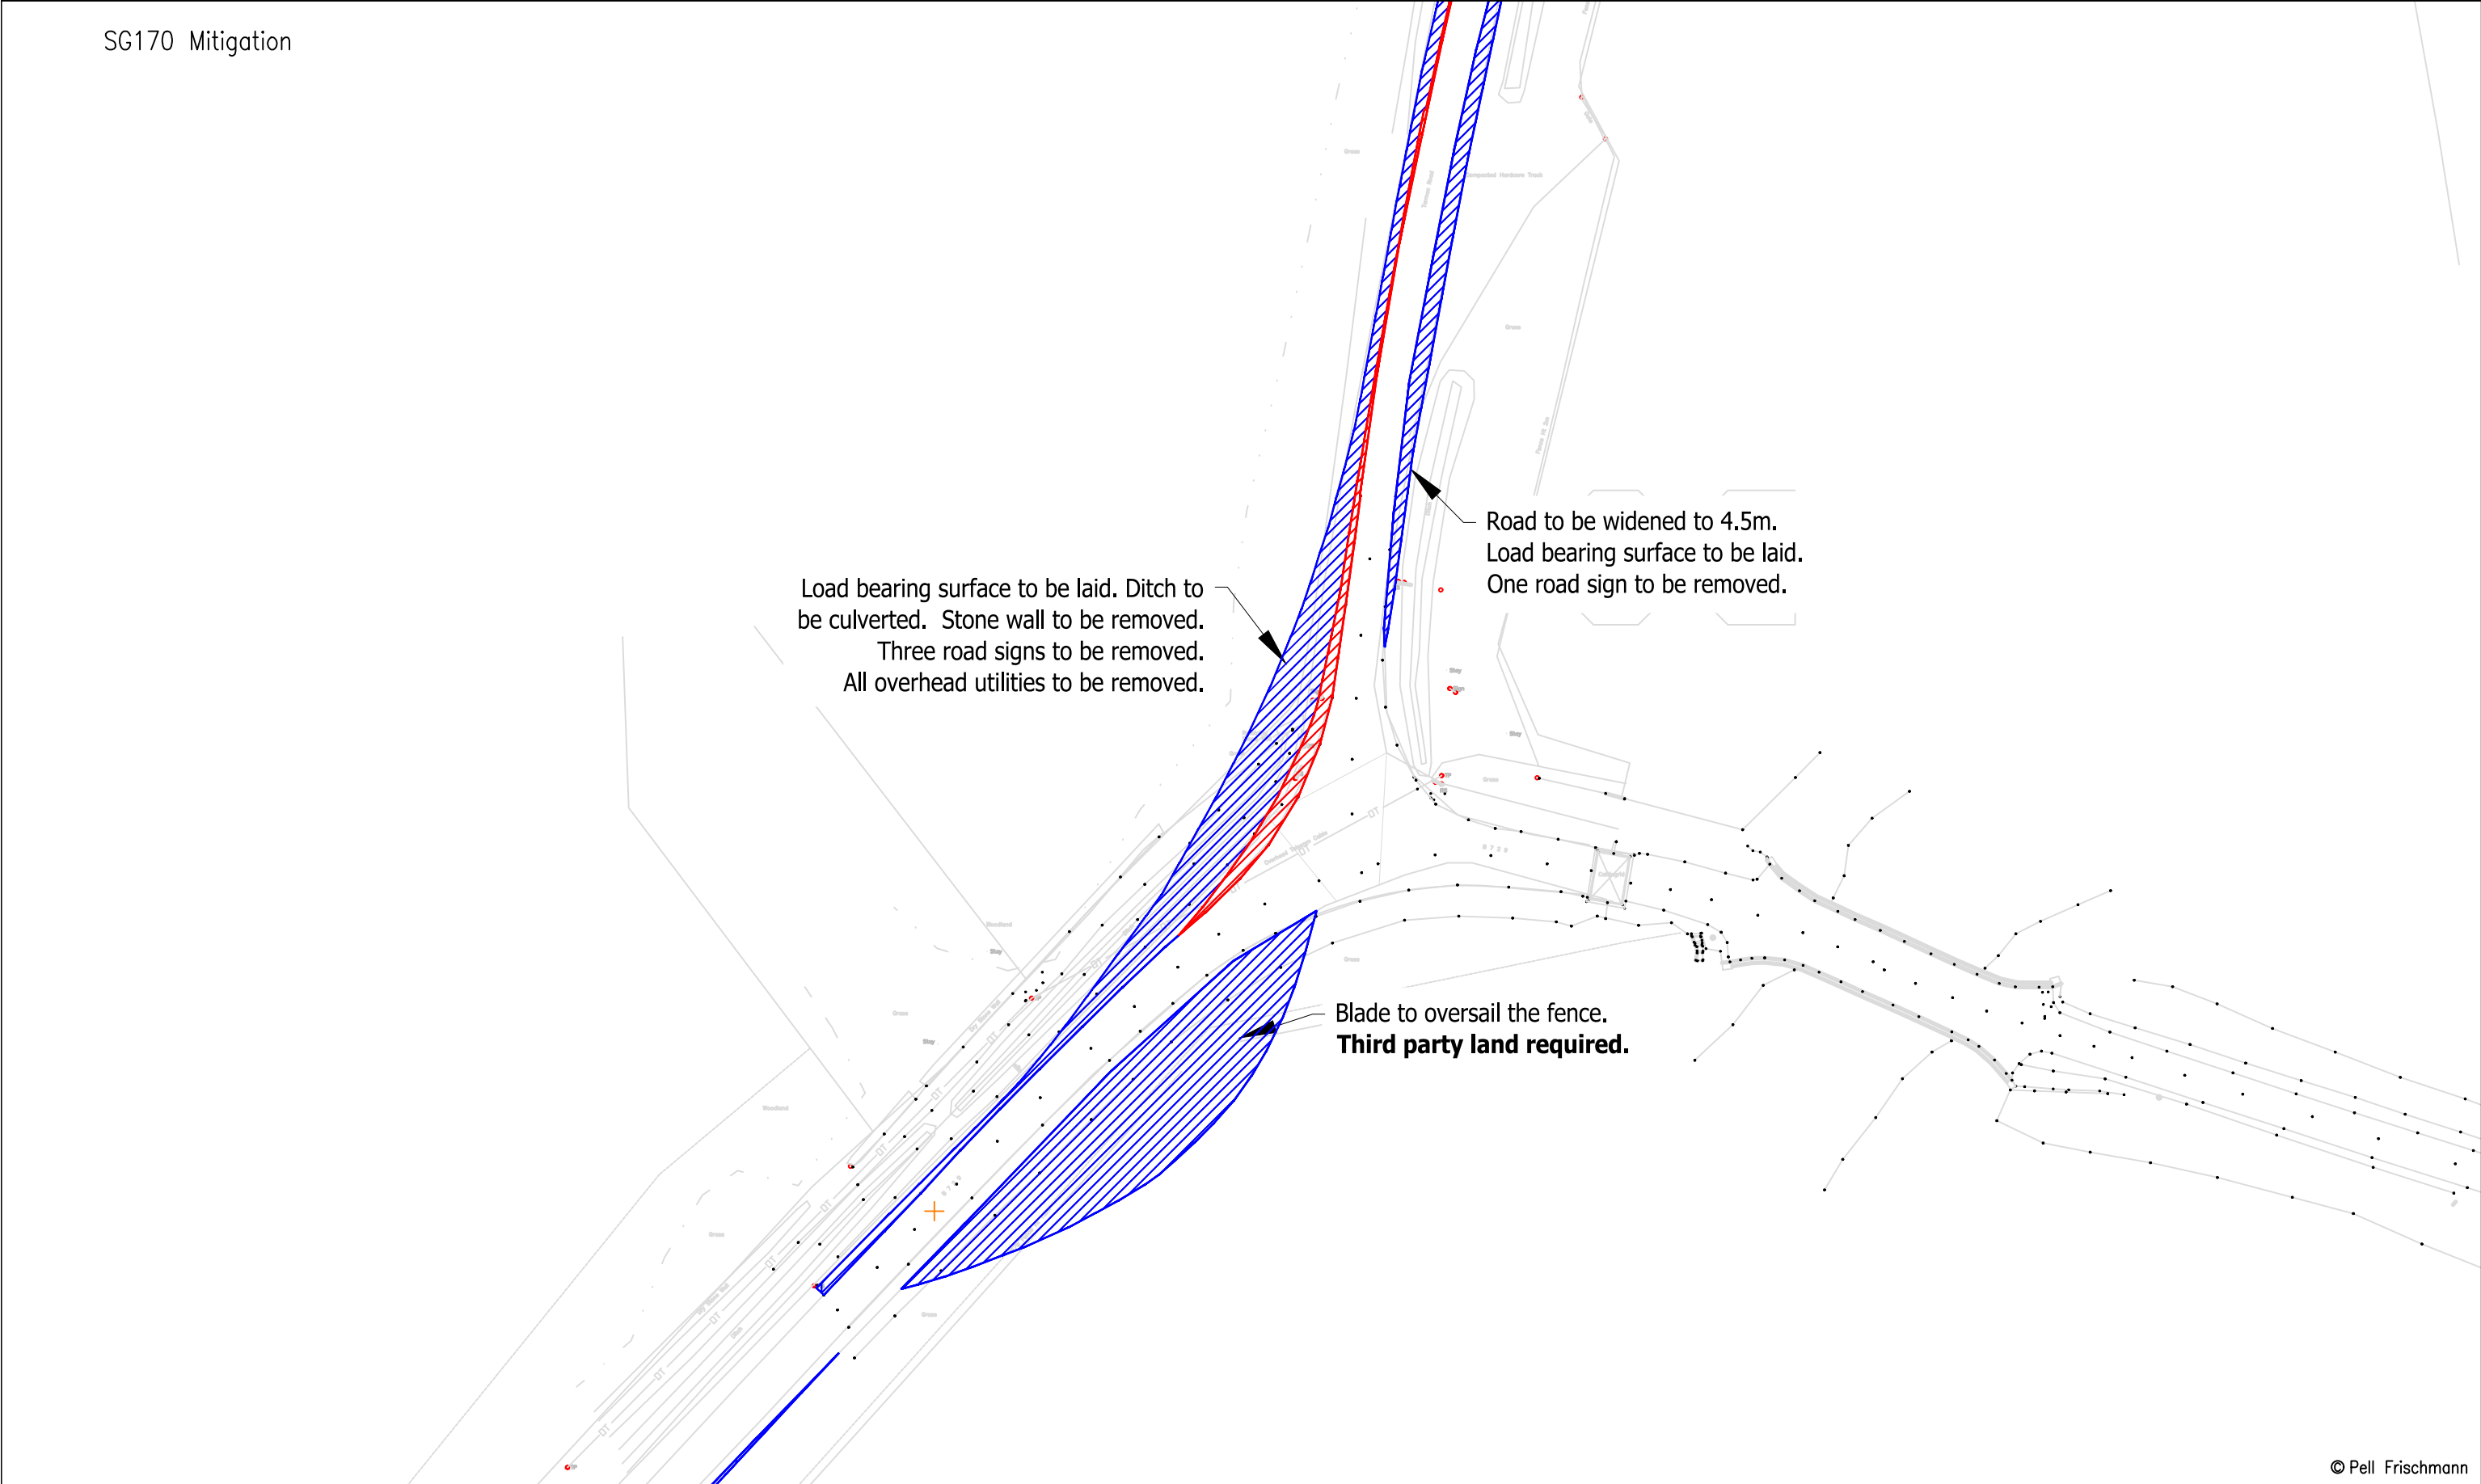


© Pell Frischmann

Pell Frischmann 93 GEORGE STREET, EDINBURGH, EH2 3ES Tel: +44 (0) 131 240 1270 Email: pfredinburgh@pellfrischmann.com www.pellfrischmann.com	Project	Appin Wind Farm		Name	Date	Scale	
			Drawn	GLJ	15/07/2022	1:500 @ A3	
			Designed	GLJ	15/07/2022	220622 - Appin Tracking [SG155 N163 SG170]_Part2	
			Checked	GB	15/07/2022	Final.dwg	
Client	Drawing Title	SG155 / N163 / SG170 Blades & 29.977 x 4.8 x 4.793 Tower	Point of Interest		90	Drawing Status	
						Draft	
Key	SPA Location	B729 / Water o Ken Junction	Drawing No.	SK55E	Notes:		Revision
					1. All mitigation is subject to confirmation through a test run. 2. This is not a construction drawing and is intended for illustration purposes only.		
Wheel SPA	Body SPA						1
Load SPA	Indicative						
Over-run	Over-sail						


SG155 Blade

Tower

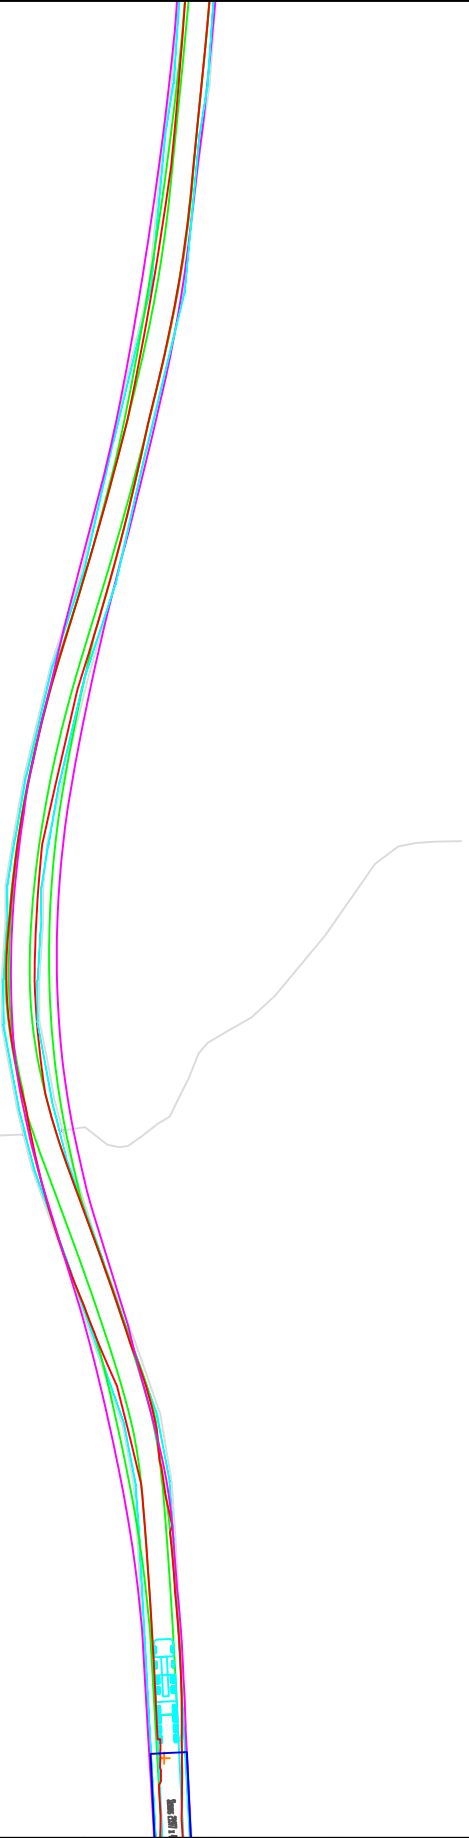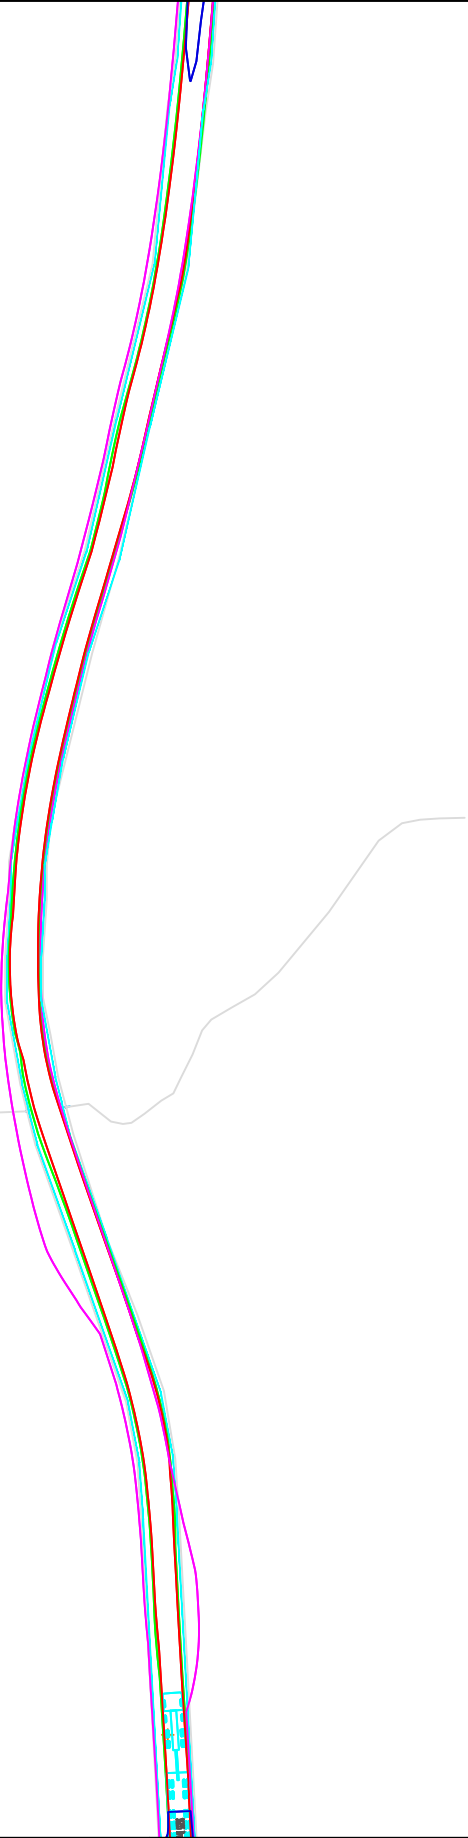

© Pell Frischmann

Pell Frischmann 93 GEORGE STREET, EDINBURGH, EH2 3ES Tel: +44 (0)131 240 1270 Email: p.fedinburgh@pellfrischmann.com www.pellfrischmann.com	Project	Appin Wind Farm			Name	Date	Scale						
				Drawn	GLJ	15/07/2022	1:1000 @ A3						
				Designed	GLJ	15/07/2022	220622 - Appin Tracking [SG155 N163 SG170]_Part2						
				Checked	GB	15/07/2022	Final.dwg						
Client	Statkraft	Drawing Title	SG155 / N163 / SG170 Blades & 29.977 x 4.8 x 4.793 Tower		Point of Interest		91	Drawing Status					
					Draft								
Key	Wheel SPA	Body SPA	Load SPA	Indicative	Over-run	Over-sail	SPA Location	Water of Ken Road South of Craigengillan	Drawing No.	SK56	Notes: 1. All mitigation is subject to confirmation through a test run. 2. This is not a construction drawing and is intended for illustration purposes only.	Revision	1

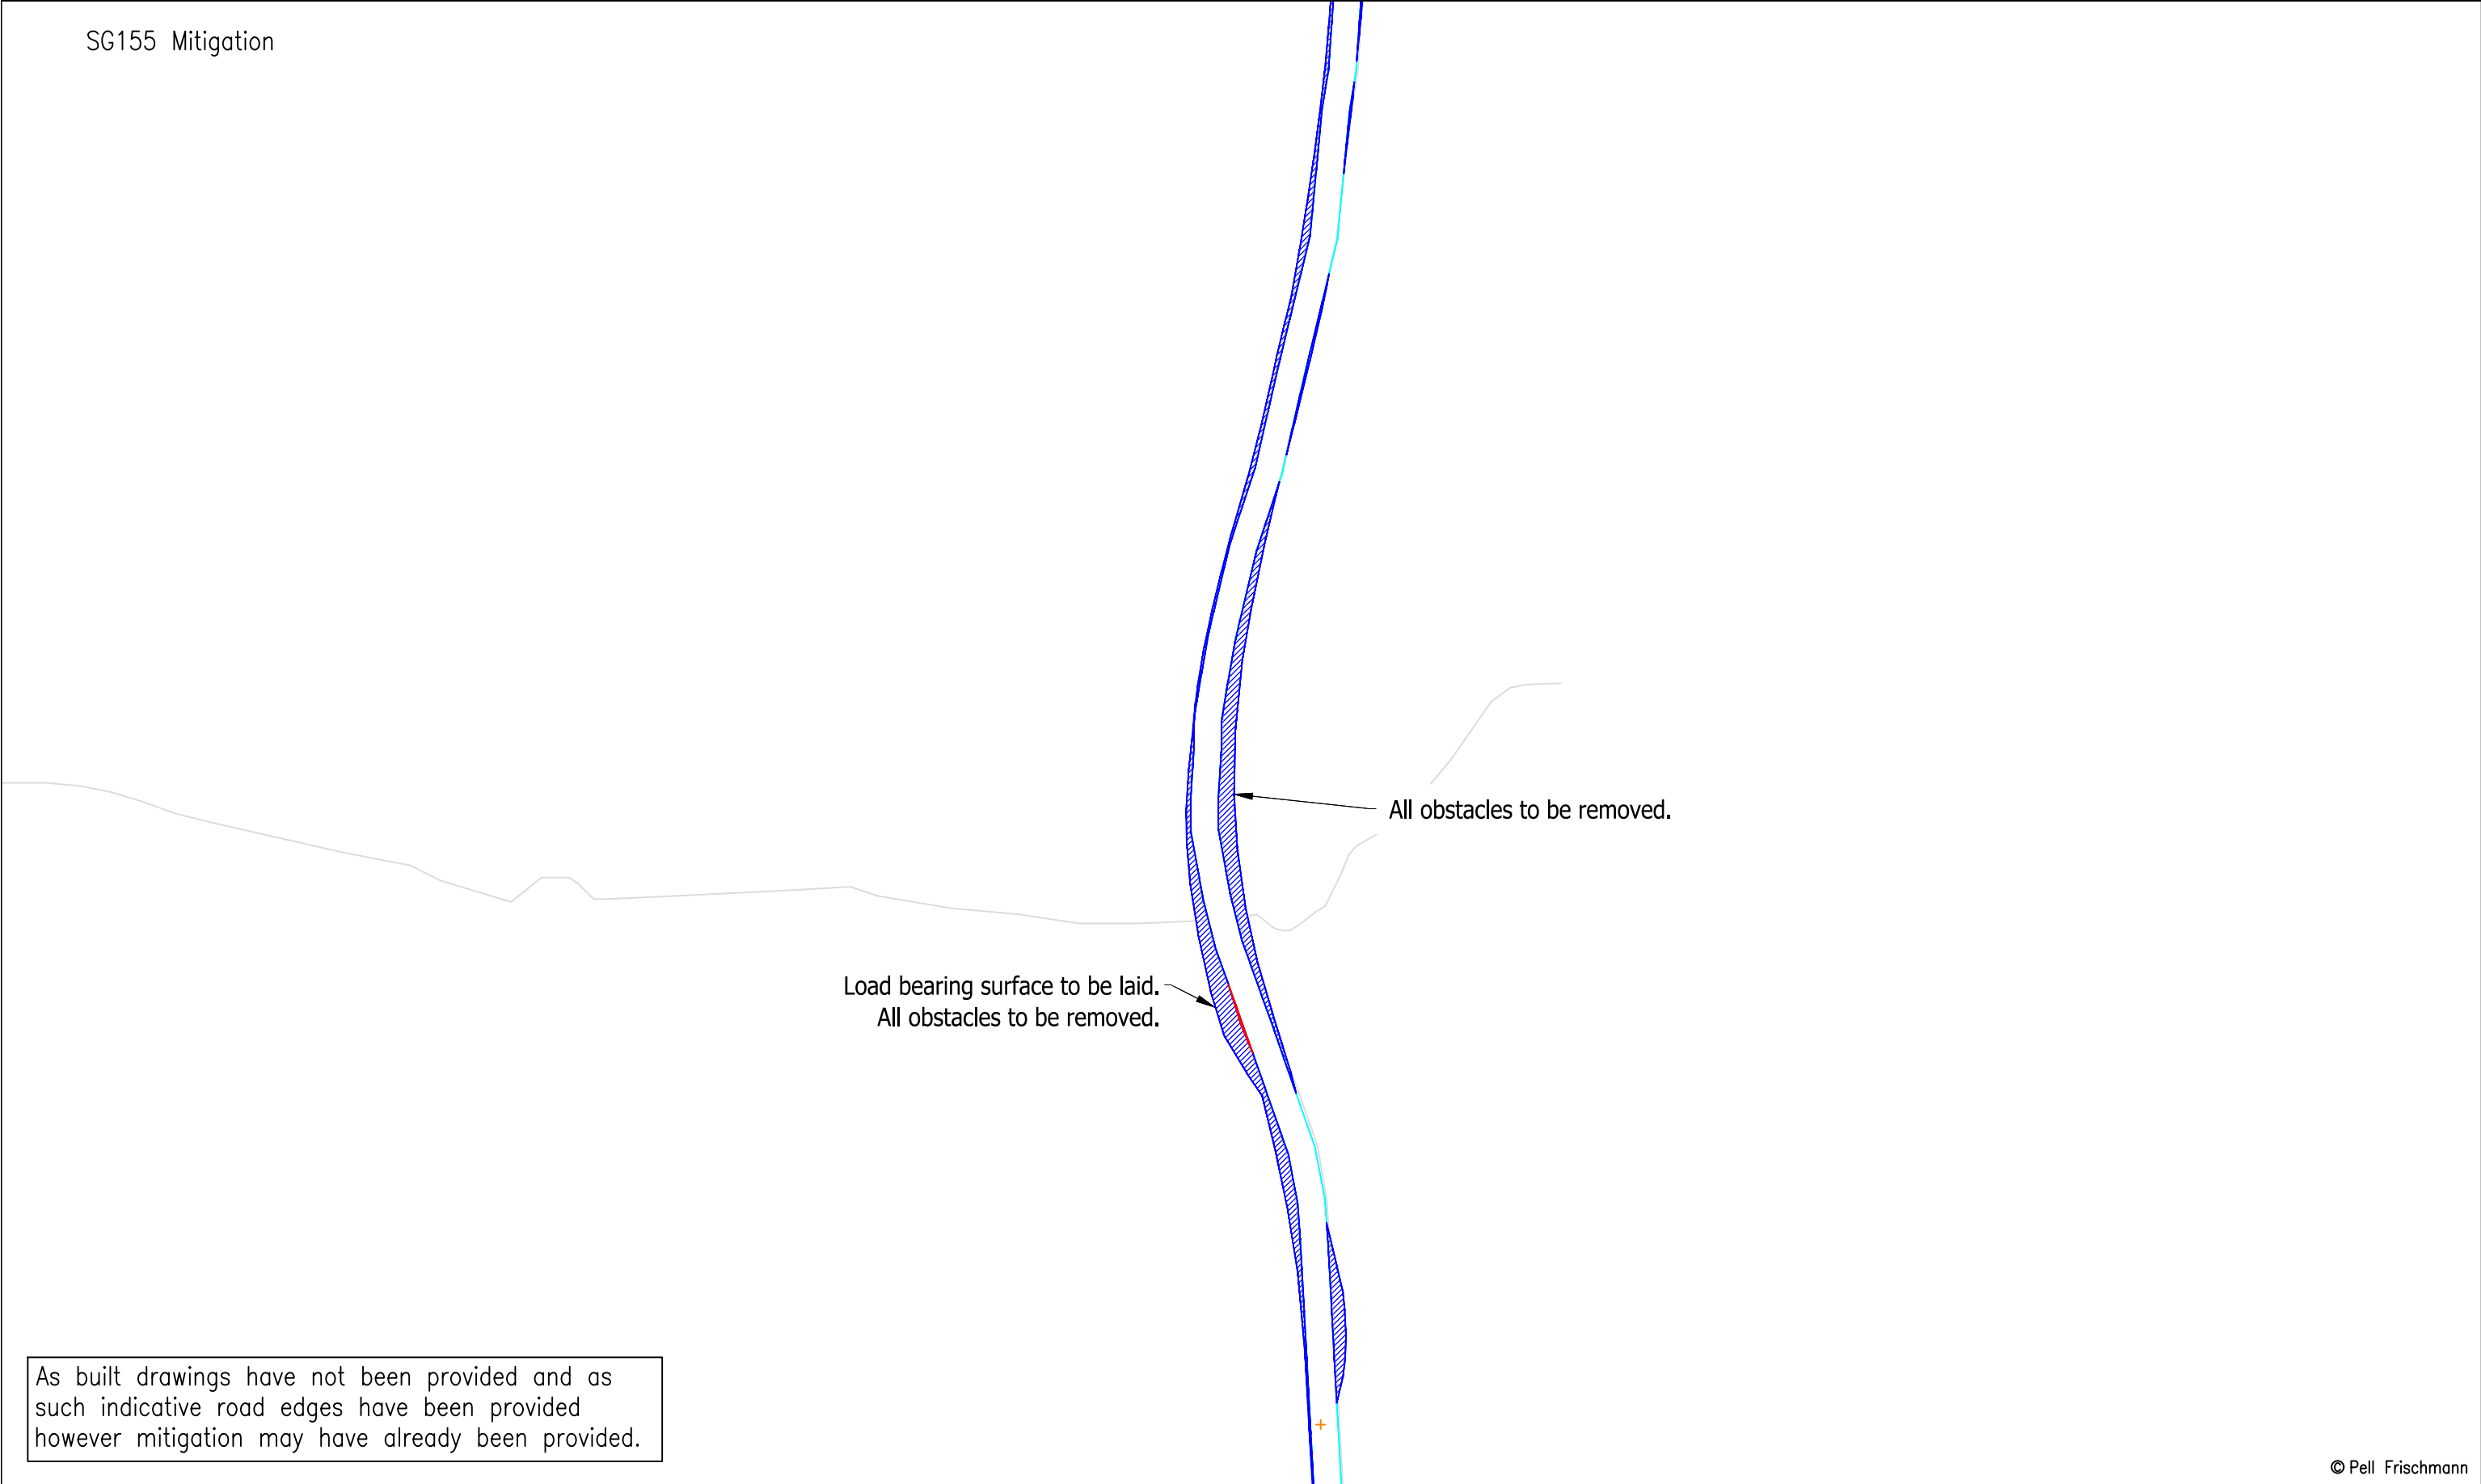

© Pell Frischmann


Pell Frischmann 93 GEORGE STREET, EDINBURGH, EH2 3ES Tel: +44 (0)131 240 1270 Email: p.fedinburgh@pellfrischmann.com www.pellfrischmann.com	Project	Appin Wind Farm			Name	Date	Scale	
				Drawn	GLJ	15/07/2022	1:1000 @ A3	
				Designed	GLJ	15/07/2022	220622 - Appin Tracking [SG155 N163 SG170]_Part2	
				Checked	GB	15/07/2022	Final.dwg	
Client	Statkraft	Drawing Title	SG155 / N163 / SG170 Blades & 29.977 x 4.8 x 4.793 Tower		Point of Interest		91	Drawing Status
					Draft			
Key	Wheel SPA Body SPA Load SPA Indicative Over-run Over-sail	SPA Location	Water of Ken Road South of Craigengillan		Drawing No.	SK56A	Notes: 1. All mitigation is subject to confirmation through a test run. 2. This is not a construction drawing and is intended for illustration purposes only.	Revision
								1

Key						
	Wheel SPA	Body SPA	Load SPA	Indicative	Over-run	Over-sail

N163 Blade

The map shows the River Rhine flowing from the top left towards the bottom right. A red dot on the right bank of the river marks the location of the Tower of London. A scale bar at the bottom left indicates a distance of 1000 meters. A north arrow is located at the bottom right. The text 'Tower' is written in the top left corner.

Pell Frischmann 93 GEORGE STREET, EDINBURGH, EH2 3ES Tel: +44 (0)131 240 1270 Email: pfredinburgh@pellfrischmann.com www.pellfrischmann.com	Project Appin Wind Farm		Name	Date	Scale			
		Drawn	GLJ	15/07/2022	210622-Appin Tracking [SG155 N163 SG170]_Part2 Final.dwg			
		Designed	GLJ	15/07/2022				
		Checked	GB	15/07/2022				
Client Statkraft	Drawing Title	SG155 / N163 / SG170 Blades & 29.977 x 4.8 x 4.793 Tower			Point of Interest	91	Drawing Status	Draft
	SPA Location	Water of Ken Road South of Craigengillan			Drawing No. SK56B	Notes: 1. All mitigation is subject to confirmation through a test run. 2. This is not a construction drawing and is intended for illustration purposes only.		Revision 1

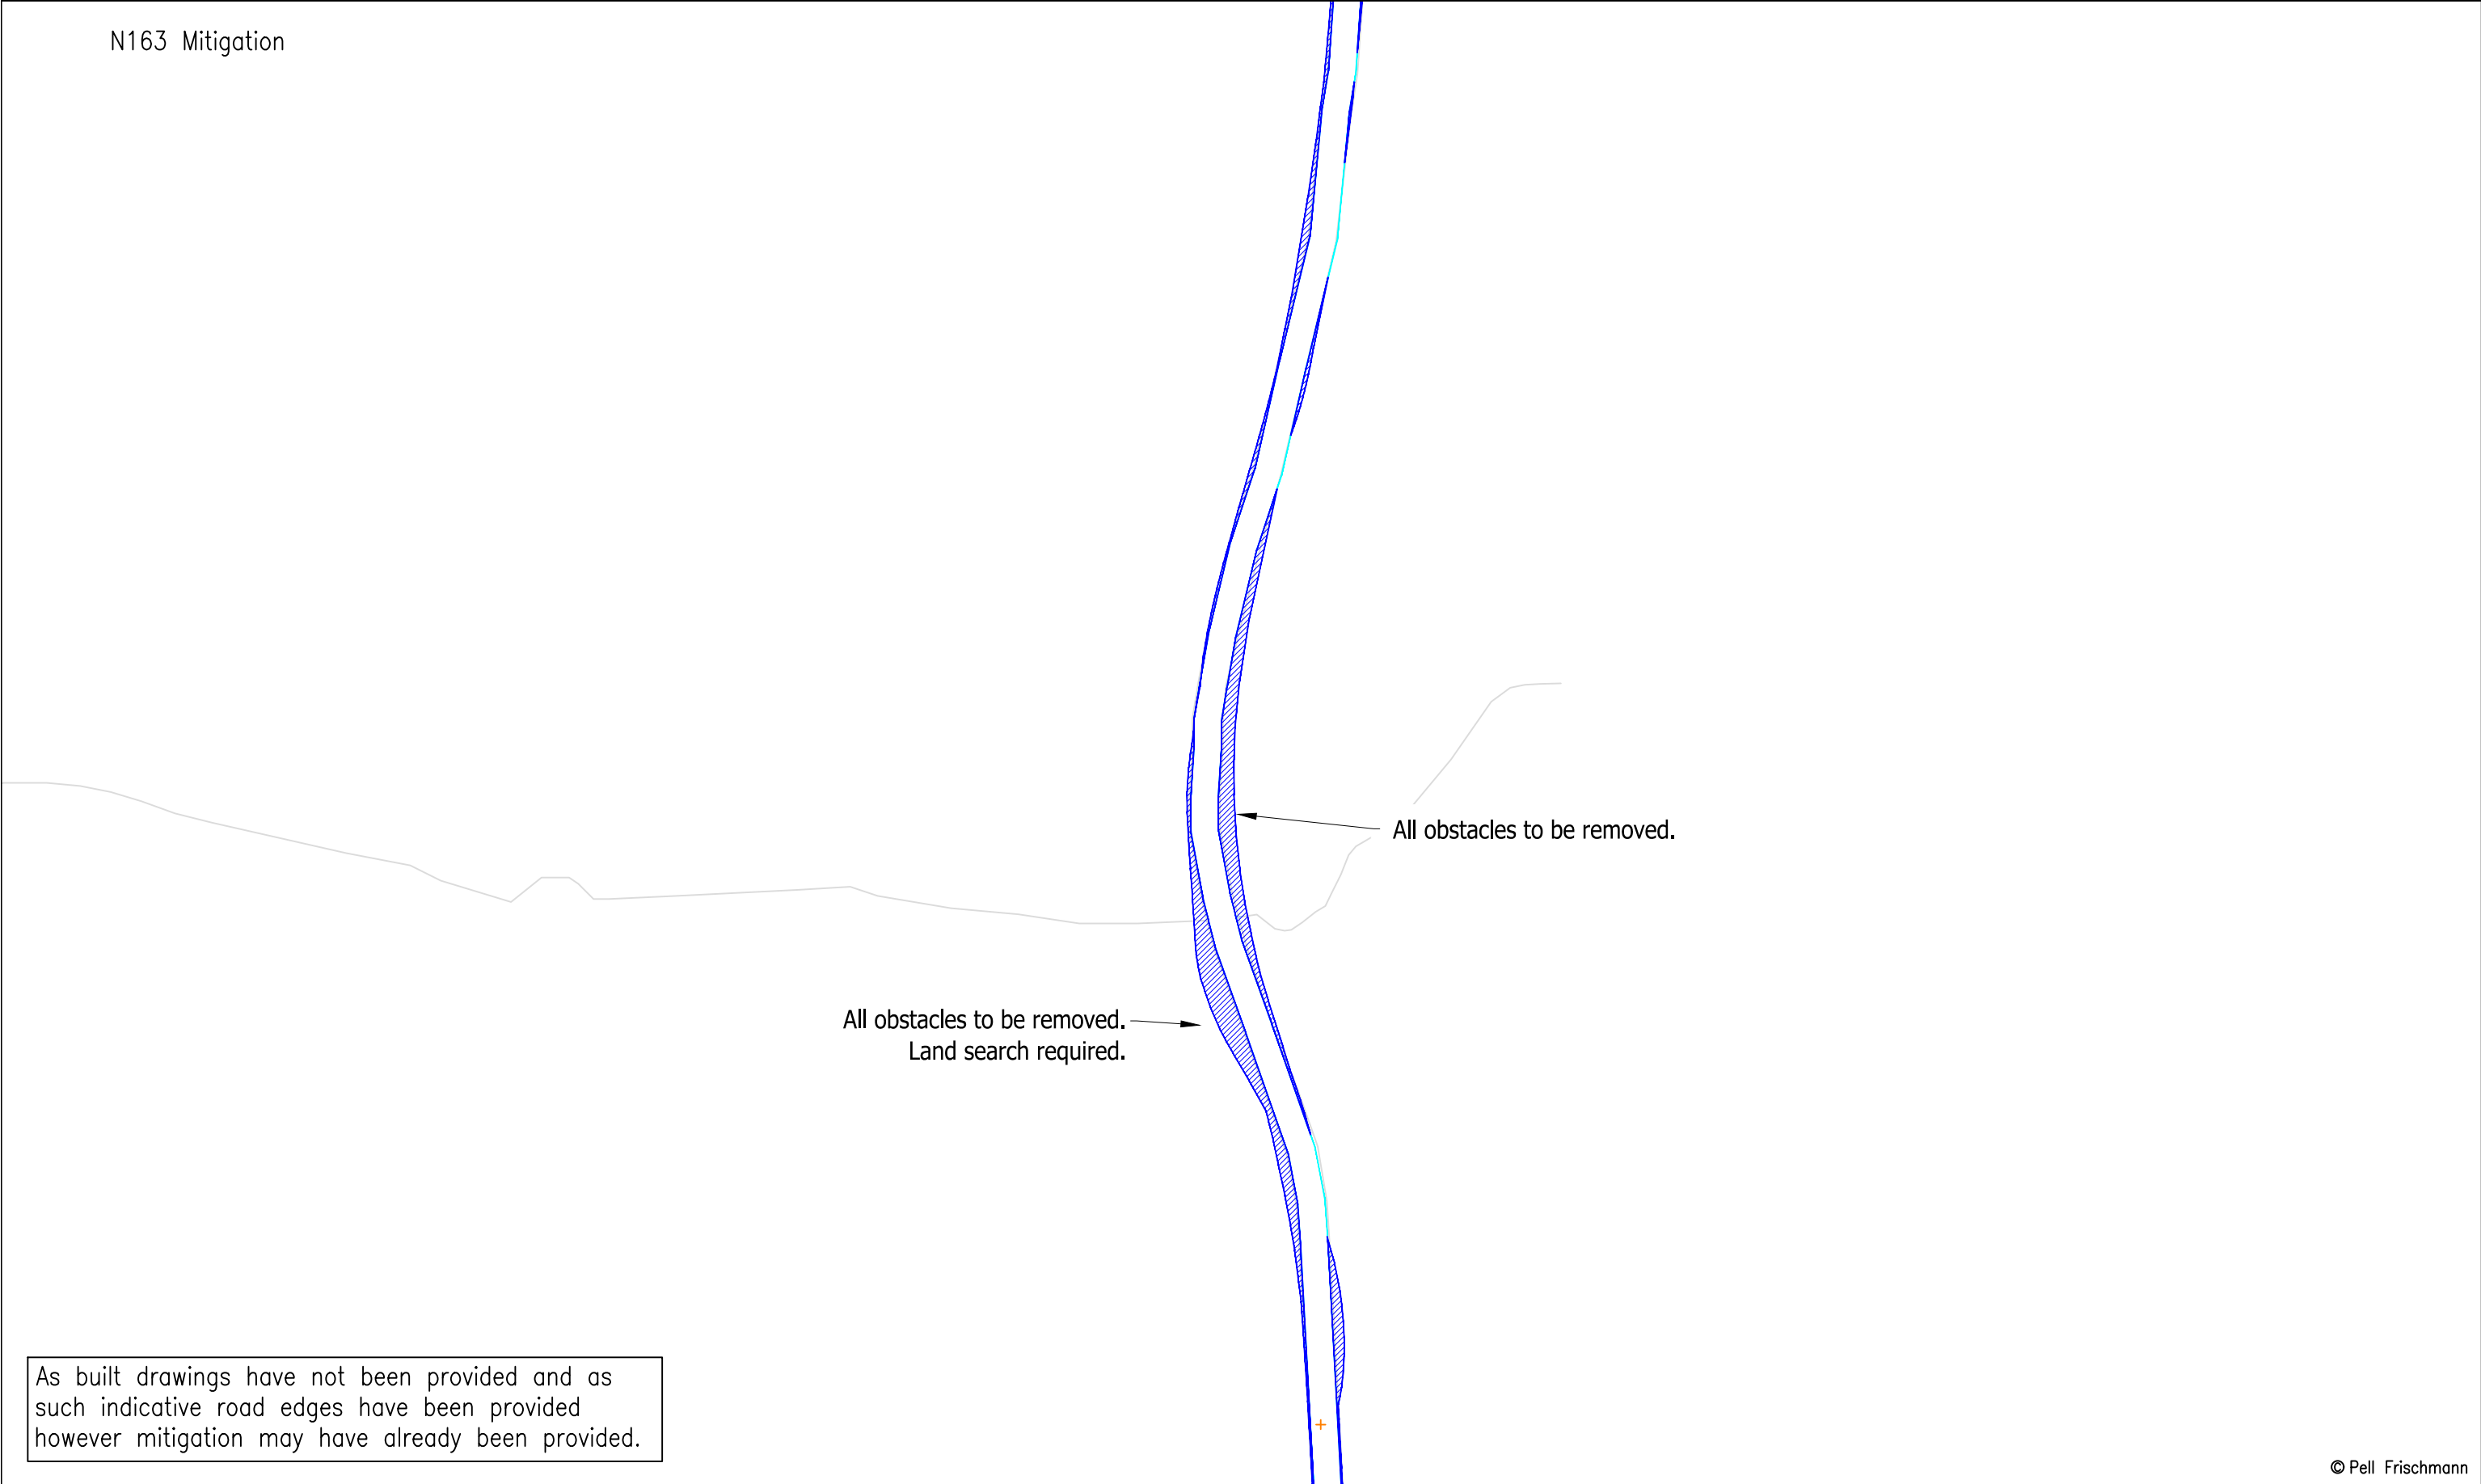

As built drawings have not been provided and as such indicative road edges have been provided however mitigation may have already been provided.

© Pell Frischmann

Pell Frischmann 93 GEORGE STREET, EDINBURGH, EH2 3ES Tel: +44 (0)131 240 1270 Email: pfredinburgh@pellfrischmann.com www.pellfrischmann.com	Project Appin Wind Farm			Name	Date	Scale 1:1000 @ A3		
			Drawn	GLJ	15/07/2022	220622 - Appin Tracking [SG155 N163 SG170]_Part2		
			Designed	GLJ	15/07/2022	Final.dwg		
			Checked	GB	15/07/2022	Drawing Status Draft		
Client Statkraft	Drawing Title SG155 / N163 / SG170 Blades & 29.977 x 4.8 x 4.793 Tower		Point of Interest		91			
			Drawing No. SK56C		Notes: 1. All mitigation is subject to confirmation through a test run. 2. This is not a construction drawing and is intended for illustration purposes only.		Revision 1	
Key Wheel SPA Body SPA Load SPA Indicative Over-run Over-sail	SPA Location Water of Ken Road South of Craigengillan							



SG170 Blade

Tower

© Pell Frischmann

Pell Frischmann

93 GEORGE STREET, EDINBURGH, EH2 3ES

Tel: +44 (0)131 240 1270

Email: pfedinburgh@pellfrischmann.com

www.pellfrischmann.com

Client
Statkraft

Key



Wheel SPA



Body SPA



Load SPA



Indicative



Over-run



Over-sail

Project	Appin Wind Farm
Drawing Title	SG155 / N163 / SG170 Blades & 29.977 x 4.8 x 4.793 Tower
SPA Location	Water of Ken Road South of Craigengillan

	Name	Date	Scale 1:1000 @ A3
Drawn	GLJ	15/07/2022	220620-Appin Tracking [SG155 N163 SG170]_Part2 Final.dwg
Designed	GLJ	15/07/2022	
Checked	GB	15/07/2022	
Point of Interest		91	Drawing Status Draft
Drawing No. SK56D		Notes: 1. All mitigation is subject to confirmation through a test run. 2. This is not a construction drawing and is intended for illustration purposes only.	
		Revision 1	





As built drawings have not been provided and as such indicative road edges have been provided however mitigation may have already been provided.

© Pell Frischmann

Pell Frischmann 93 GEORGE STREET, EDINBURGH, EH2 3ES Tel: +44 (0)131 240 1270 Email: pfedinburgh@pellfrischmann.com www.pellfrischmann.com		Project Appin Wind Farm			Name	Date	Scale 1:1000 @ A3	
				Drawn	GLJ	15/07/2022	Drawing Title SG155 / N163 / SG170 Blades & 29.977 x 4.8 x 4.793 Tower	
				Designed	GLJ	15/07/2022		
				Checked	GB	15/07/2022		
Client Statkraft		Drawing Title SG155 / N163 / SG170 Blades & 29.977 x 4.8 x 4.793 Tower		Point of Interest		91	Drawing Status Draft	
Key Wheel SPA Body SPA Load SPA Indicative Over-run Over-sail		SPA Location Water of Ken Road South of Craigengillan		Drawing No. SK56E		Notes: 1. All mitigation is subject to confirmation through a test run. 2. This is not a construction drawing and is intended for illustration purposes only.		Revision 1


SG155 Blade

Tower

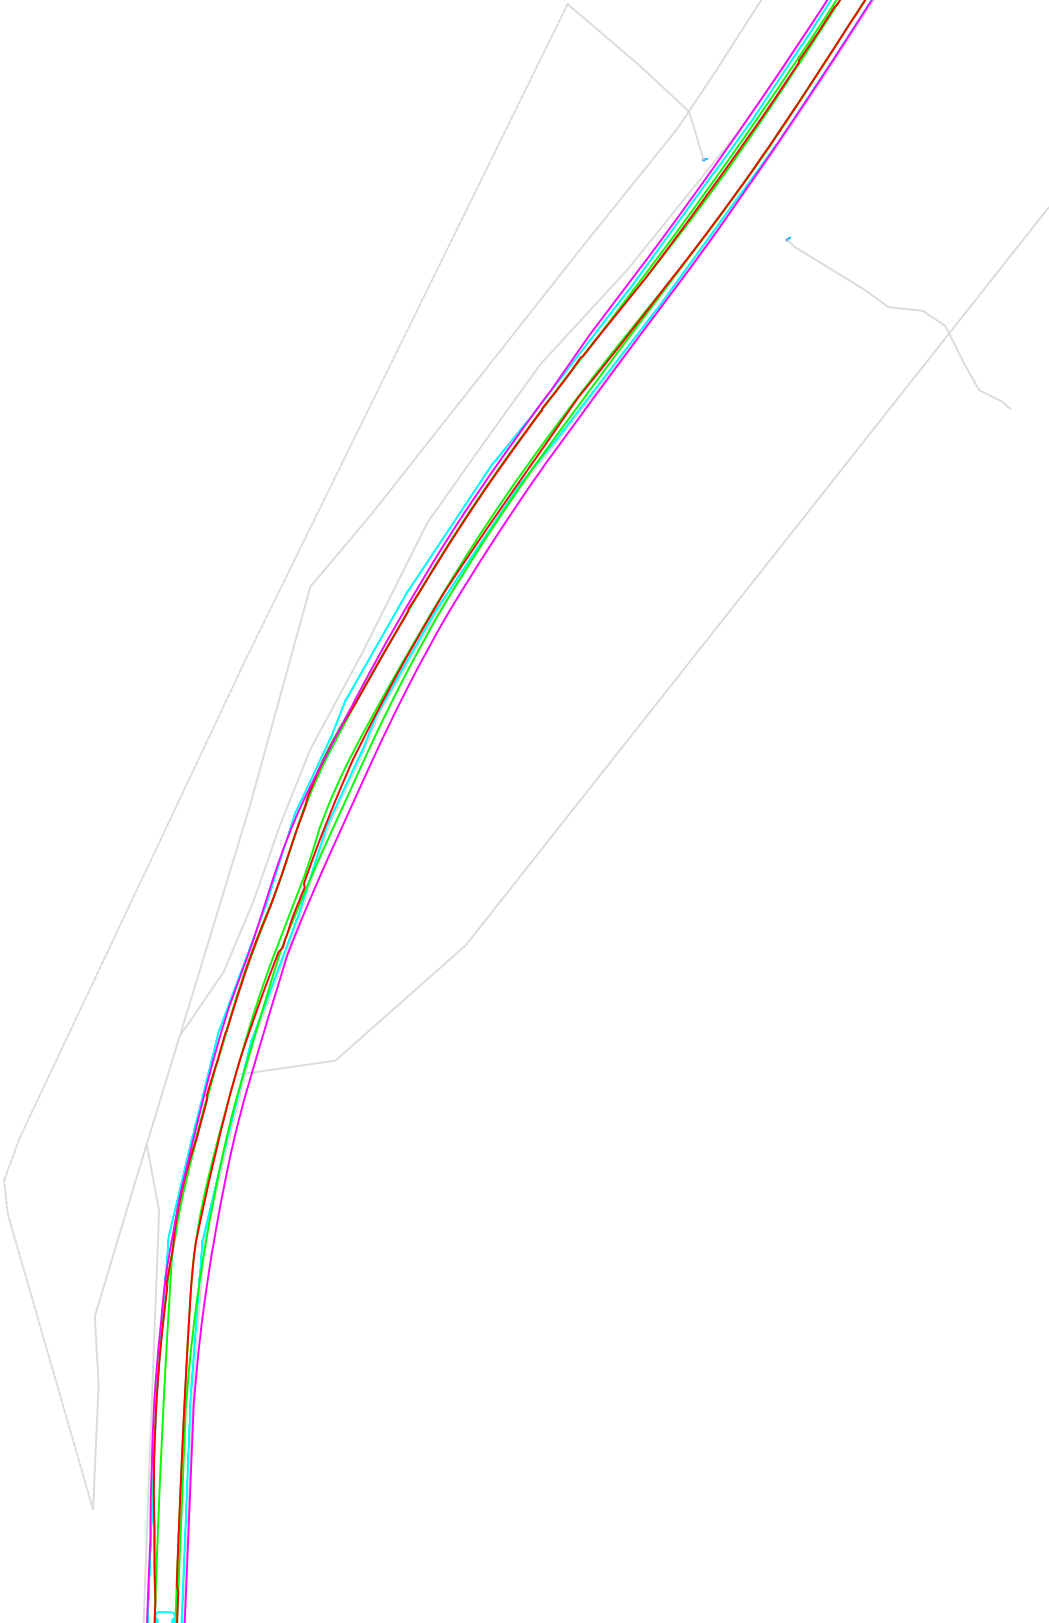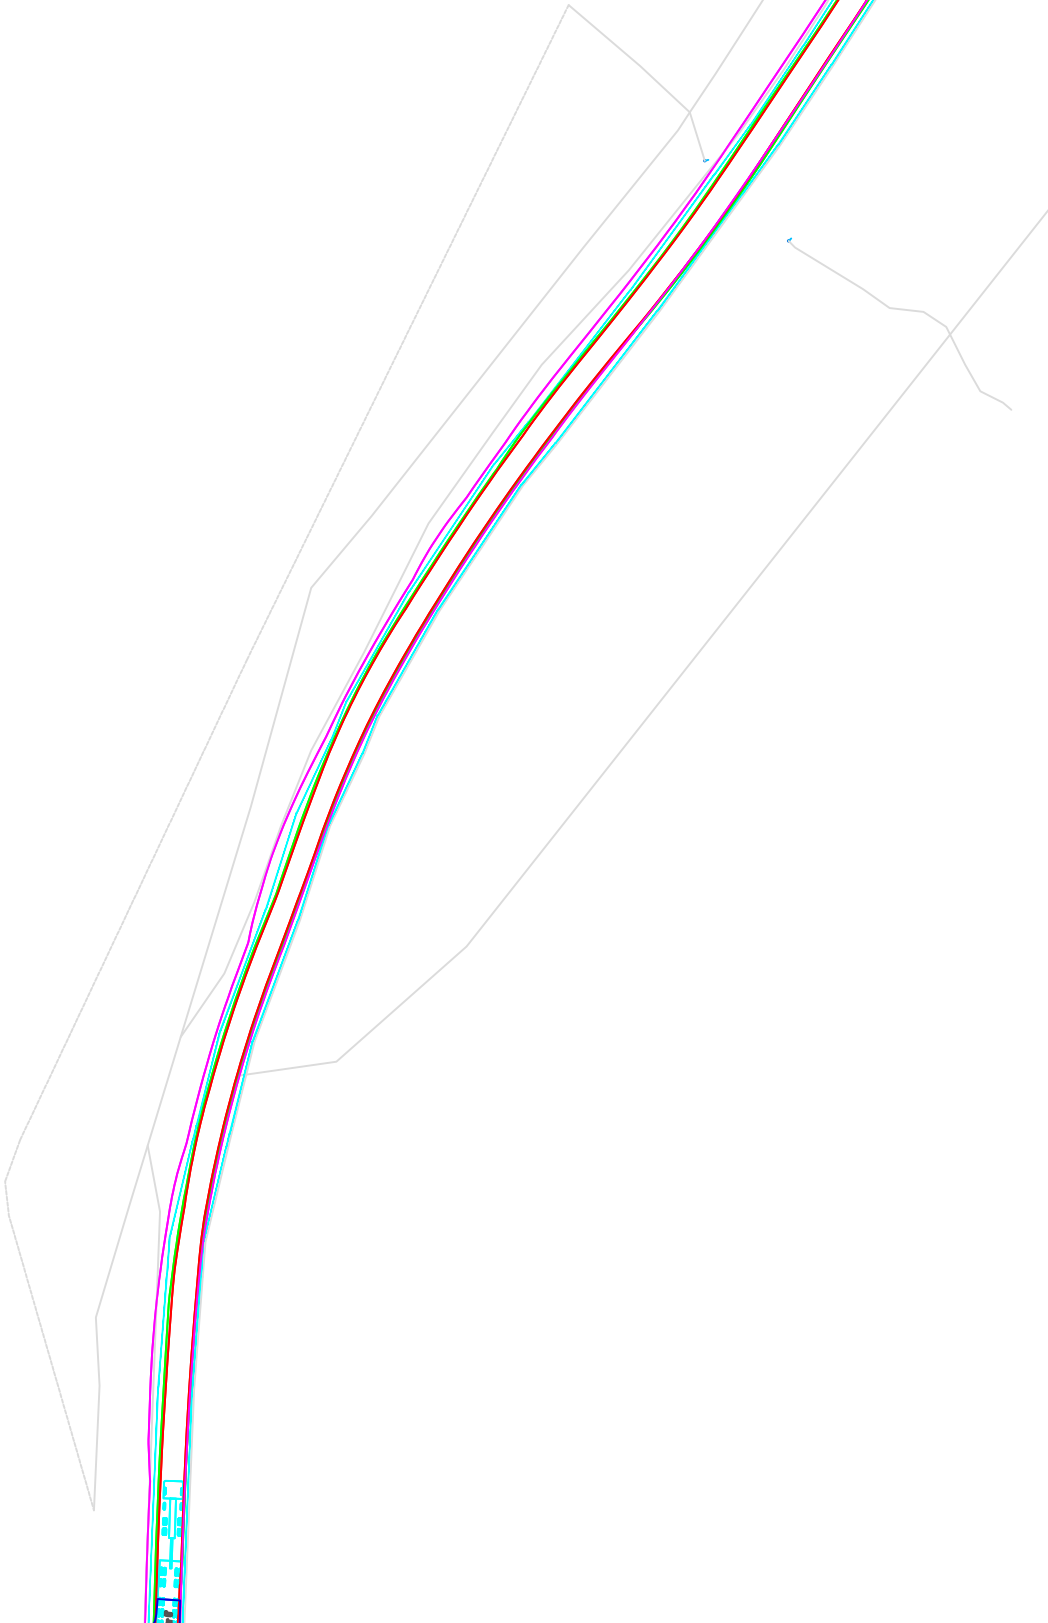

© Pell Frischmann

Pell Frischmann 93 GEORGE STREET, EDINBURGH, EH2 3ES Tel: +44 (0)131 240 1270 Email: pfedinburgh@pellfrischmann.com www.pellfrischmann.com		Project		Name		Date	Scale	
		Appin Wind Farm		GLJ		15/07/2022	1:1000 @ A3	
		SG155 / N163 / SG170 Blades & 29.977 x 4.8 x 4.793 Tower		GLJ		15/07/2022	20620 - Appin Tracking [SG155 N163 SG170]_Part2	
		Water of Ken Road Craigengillan Burn		GB		15/07/2022	Final.dwg	
Client		Statkraft		Point of Interest		92	Drawing Status	
Key Wheel SPA Body SPA Load SPA Indicative Over-run Over-sail		Drawing Title		Drawing No.		Notes:		Revision
		SG155 / N163 / SG170 Blades & 29.977 x 4.8 x 4.793 Tower		SK57		1. All mitigation is subject to confirmation through a test run. 2. This is not a construction drawing and is intended for illustration purposes only.		1

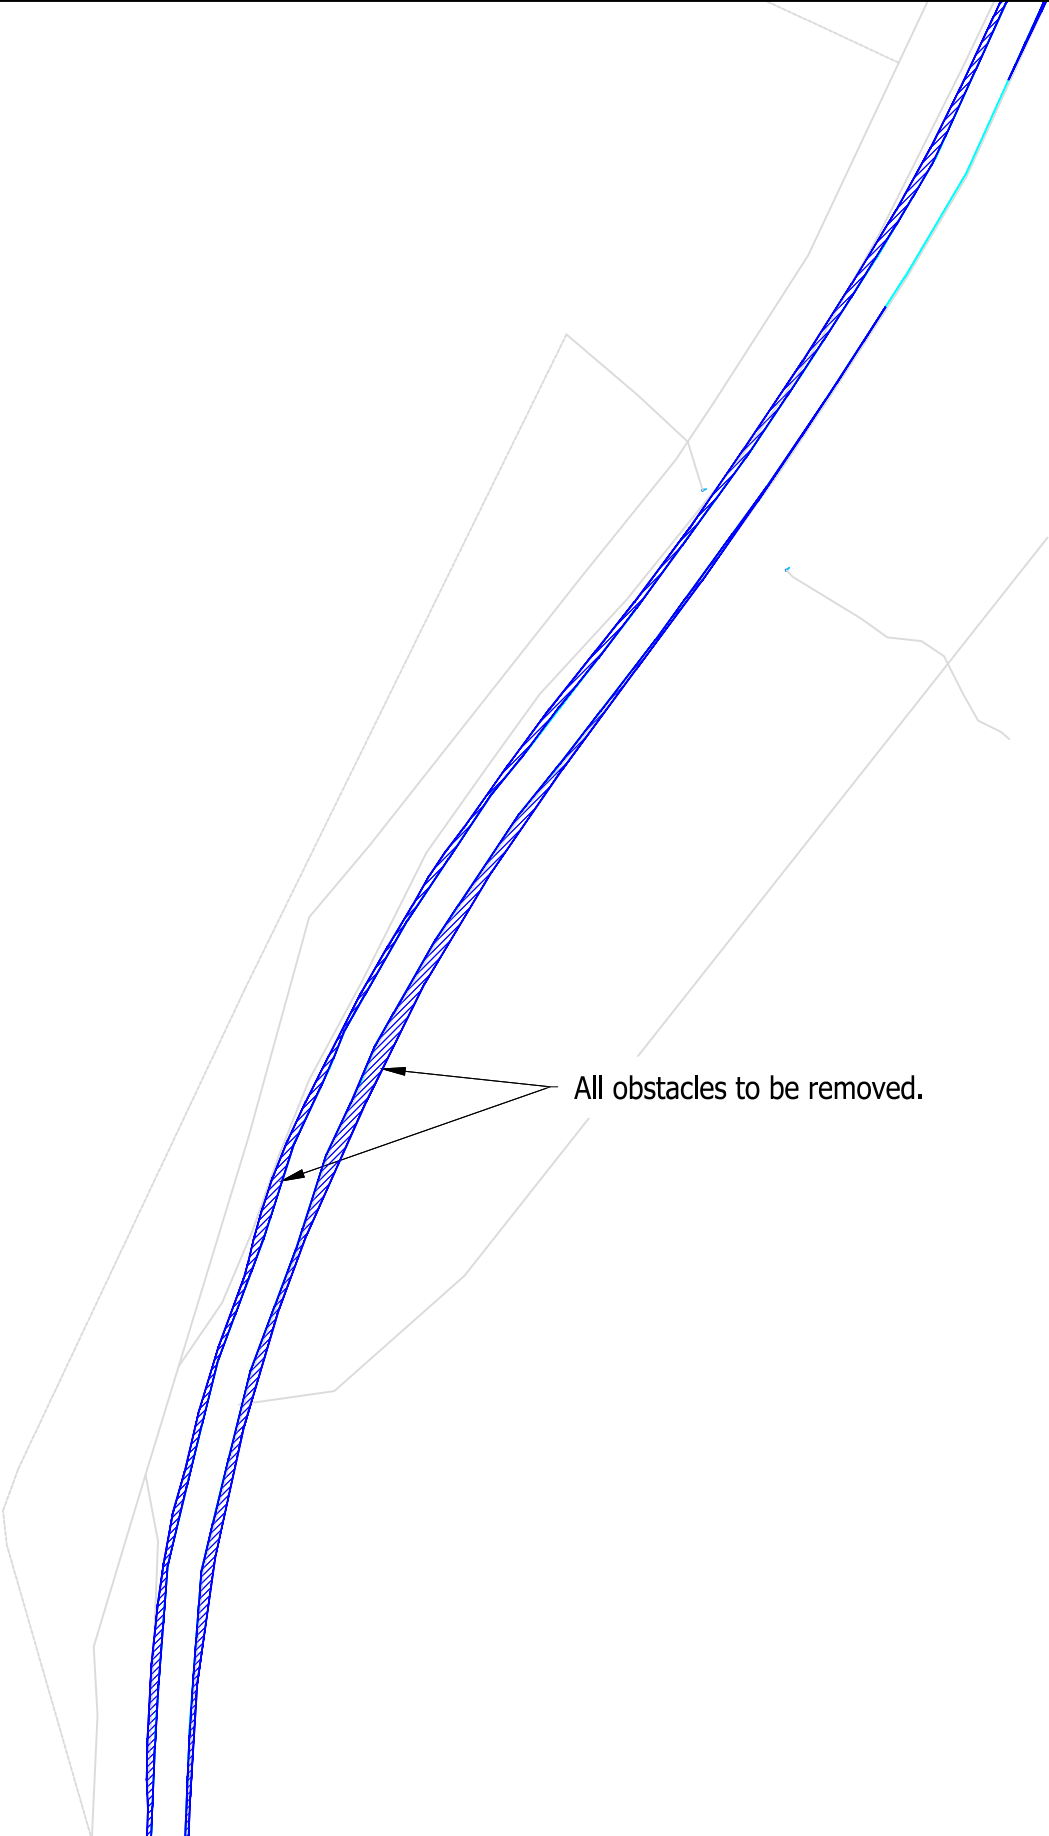


As built drawings have not been provided and as such indicative road edges have been provided however mitigation may have already been provided.

© Pell Frischmann

Pell Frischmann 93 GEORGE STREET, EDINBURGH, EH2 3ES Tel: +44 (0)131 240 1270 Email: p.fedinburgh@pellfrischmann.com www.pellfrischmann.com	Project Appin Wind Farm			Name	Date	Scale 1:1000 @ A3		
			Drawn	GLJ	15/07/2022	220622 - Appin Tracking [SG155 N163 SG170]_Part2		
			Designed	GLJ	15/07/2022	Final.dwg		
			Checked	GB	15/07/2022	Drawing Status		
Client	Statkraft		Drawing Title		Point of Interest		Draft	
		SG155 / N163 / SG170 Blades & 29.977 x 4.8 x 4.793 Tower		92				
Key Wheel SPA Body SPA Load SPA Indicative Over-run Over-sail		SPA Location Water of Ken Road Craigengillan Burn		Drawing No.		Notes:		Revision
				SK57A		1. All mitigation is subject to confirmation through a test run. 2. This is not a construction drawing and is intended for illustration purposes only.		
								1


N163 Blade

Tower

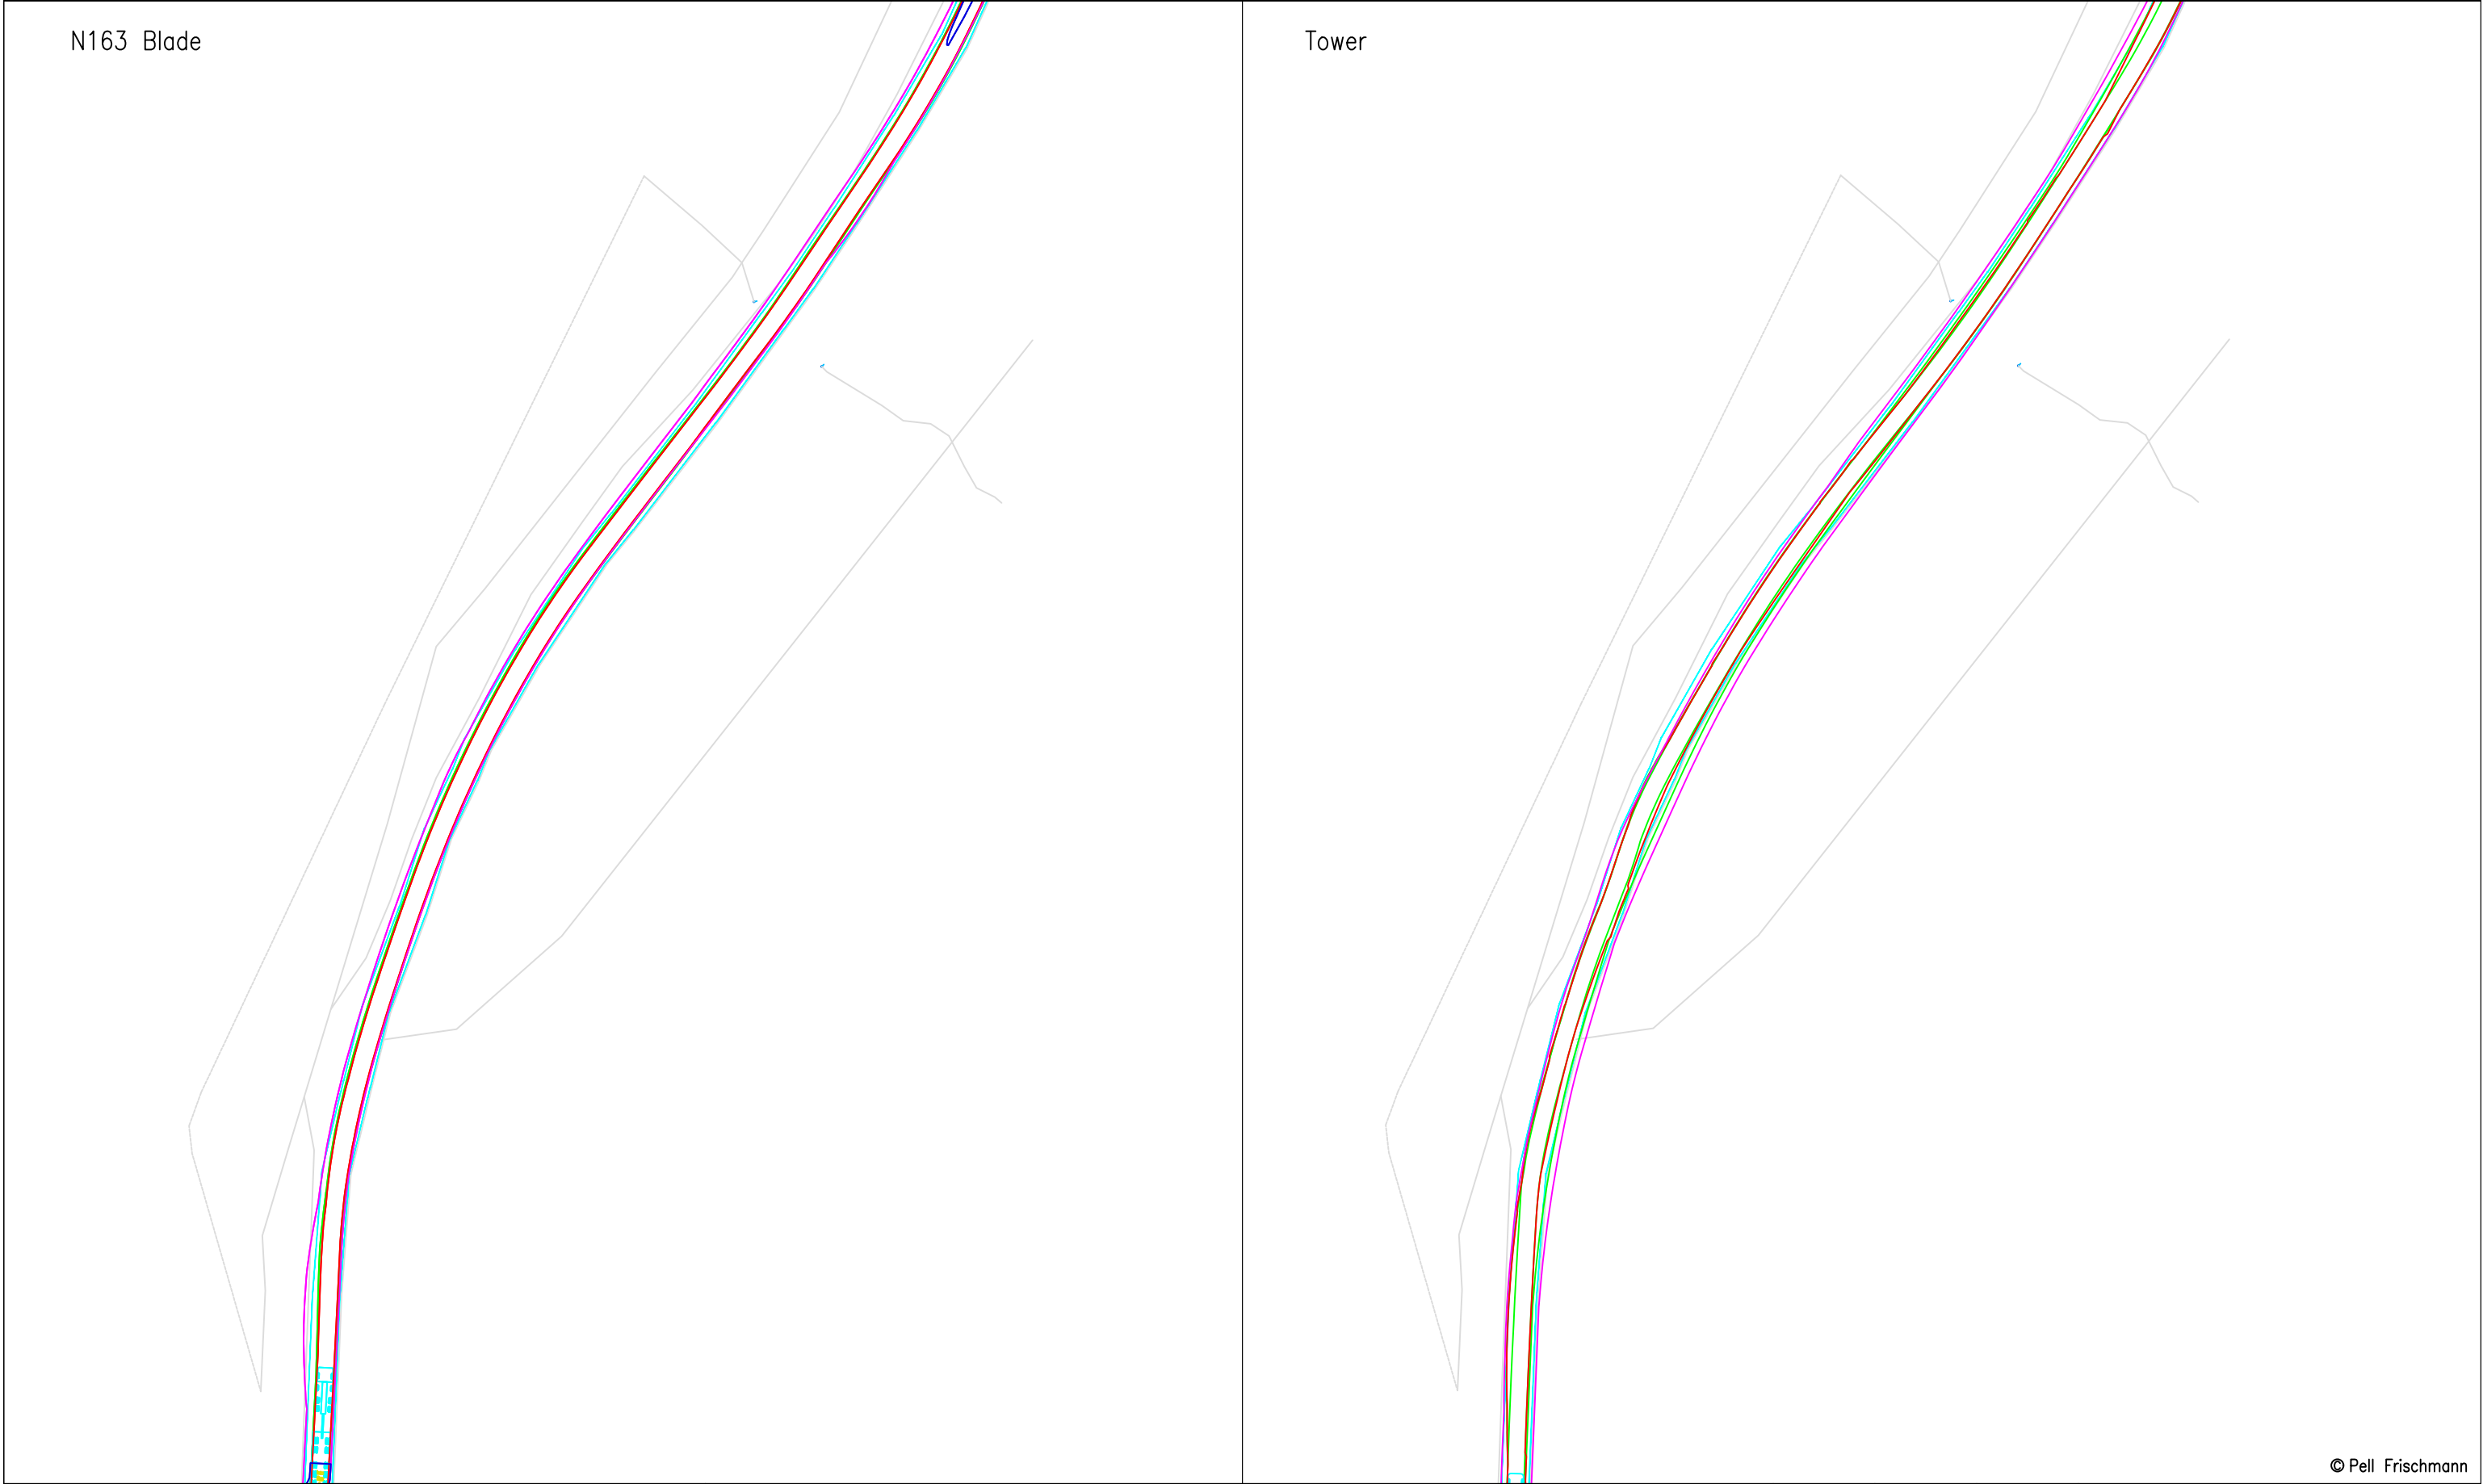

© Pell Frischmann

Pell Frischmann 93 GEORGE STREET, EDINBURGH, EH2 3ES Tel: +44 (0)131 240 1270 Email: pfedinburgh@pellfrischmann.com www.pellfrischmann.com	Project	Appin Wind Farm		Name	Date	Scale						
			Drawn	GLJ	15/07/2022	1:1000 @ A3						
			Designed	GLJ	15/07/2022	220622 - Appin Tracking [SG155 N163 SG170]_Part2						
			Checked	GB	15/07/2022	Final.dwg						
Client	Statkraft	Drawing Title	SG155 / N163 / SG170 Blades & 29.977 x 4.8 x 4.793 Tower			Point of Interest		92	Drawing Status		Draft	
			SPA Location	Water of Ken Road Craigengillan Burn			Drawing No.	SK57B	Notes: 1. All mitigation is subject to confirmation through a test run. 2. This is not a construction drawing and is intended for illustration purposes only.	Revision		1
Key											Wheel SPA	Body SPA

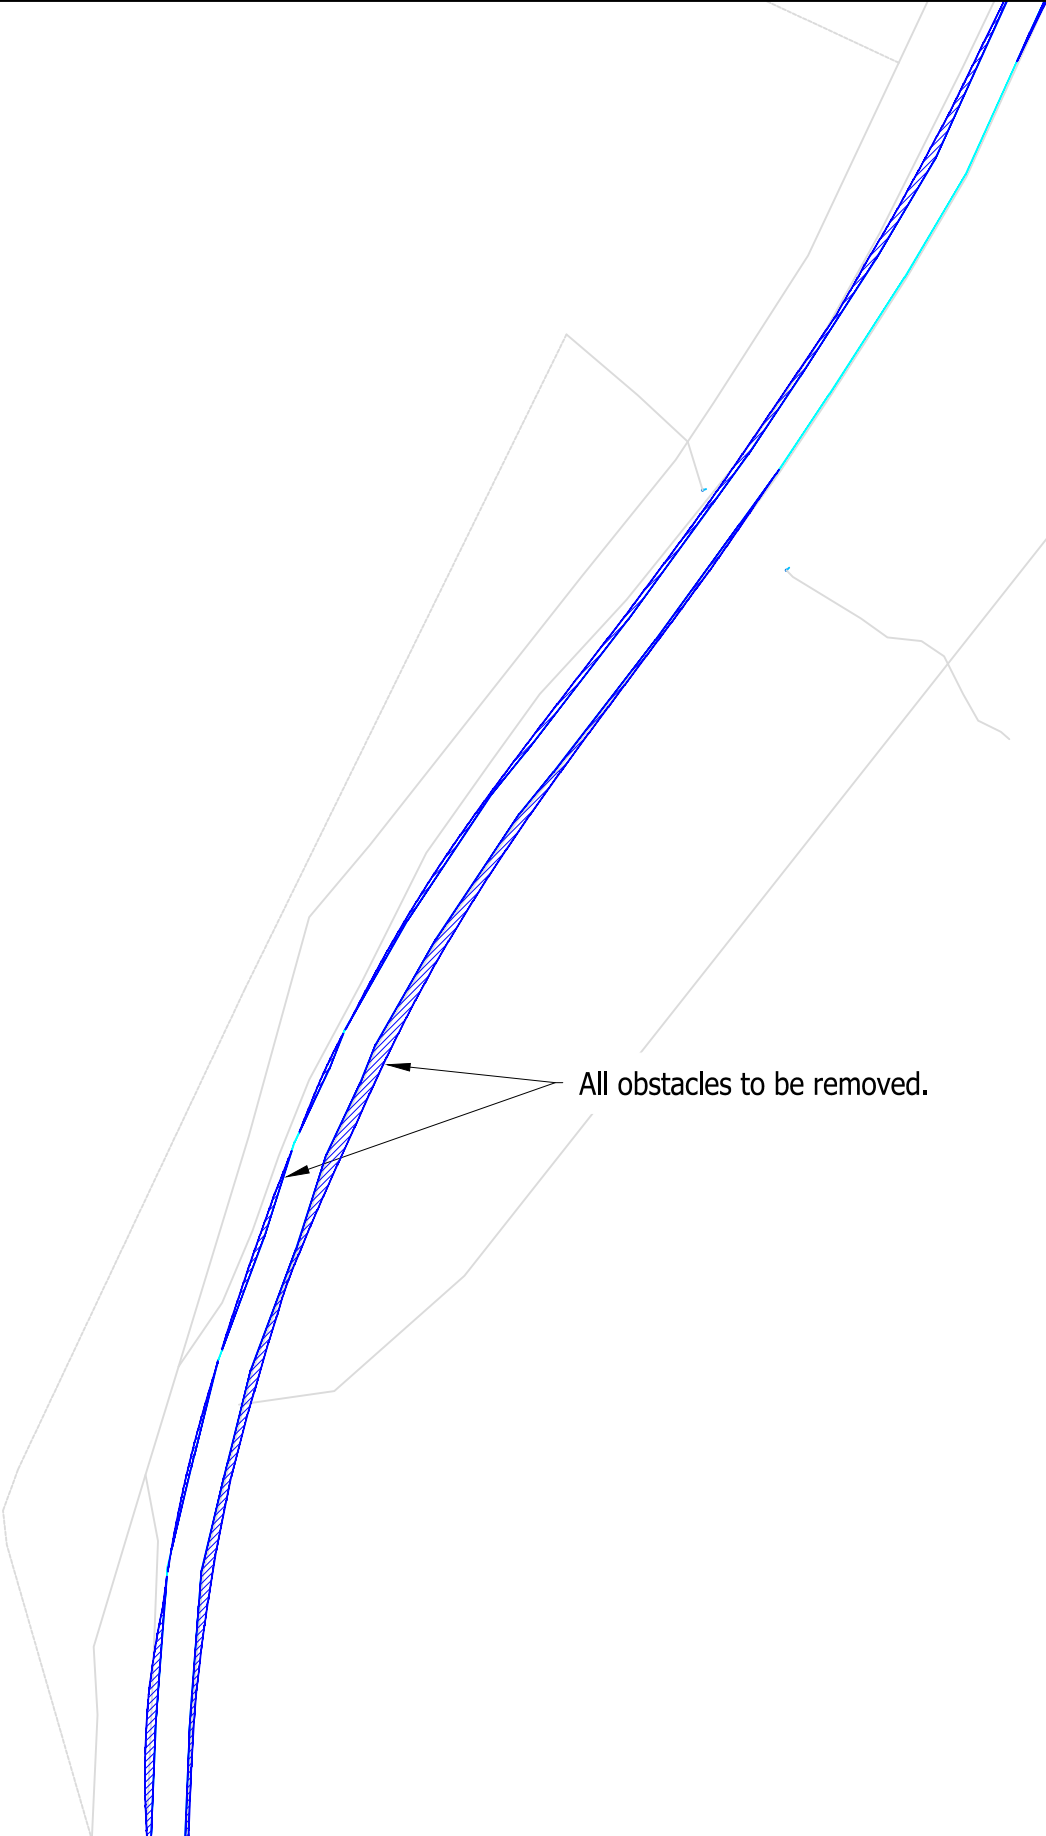


As built drawings have not been provided and as such indicative road edges have been provided however mitigation may have already been provided.


© Pell Frischmann

Pell Frischmann 93 GEORGE STREET, EDINBURGH, EH2 3ES Tel: +44 (0)131 240 1270 Email: p.fedinburgh@pellfrischmann.com www.pellfrischmann.com	Project	Appin Wind Farm			Name	Date	Scale		
				Drawn	GLJ	15/07/2022	1:1000 @ A3		
				Designed	GLJ	15/07/2022	220622 - Appin Tracking [SG155 N163 SG170]_Part2		
				Checked	GB	15/07/2022	Final.dwg		
Client	Statkraft	Drawing Title	SG155 / N163 / SG170 Blades & 29.977 x 4.8 x 4.793 Tower		Point of Interest		92	Drawing Status	
					Draft				
Key	Wheel SPA Body SPA Load SPA Indicative	SPA Location	Water of Ken Road Craigengillan Burn		Drawing No.	SK57C	Notes: 1. All mitigation is subject to confirmation through a test run. 2. This is not a construction drawing and is intended for illustration purposes only.	Revision	
								1	

SG170 Blade

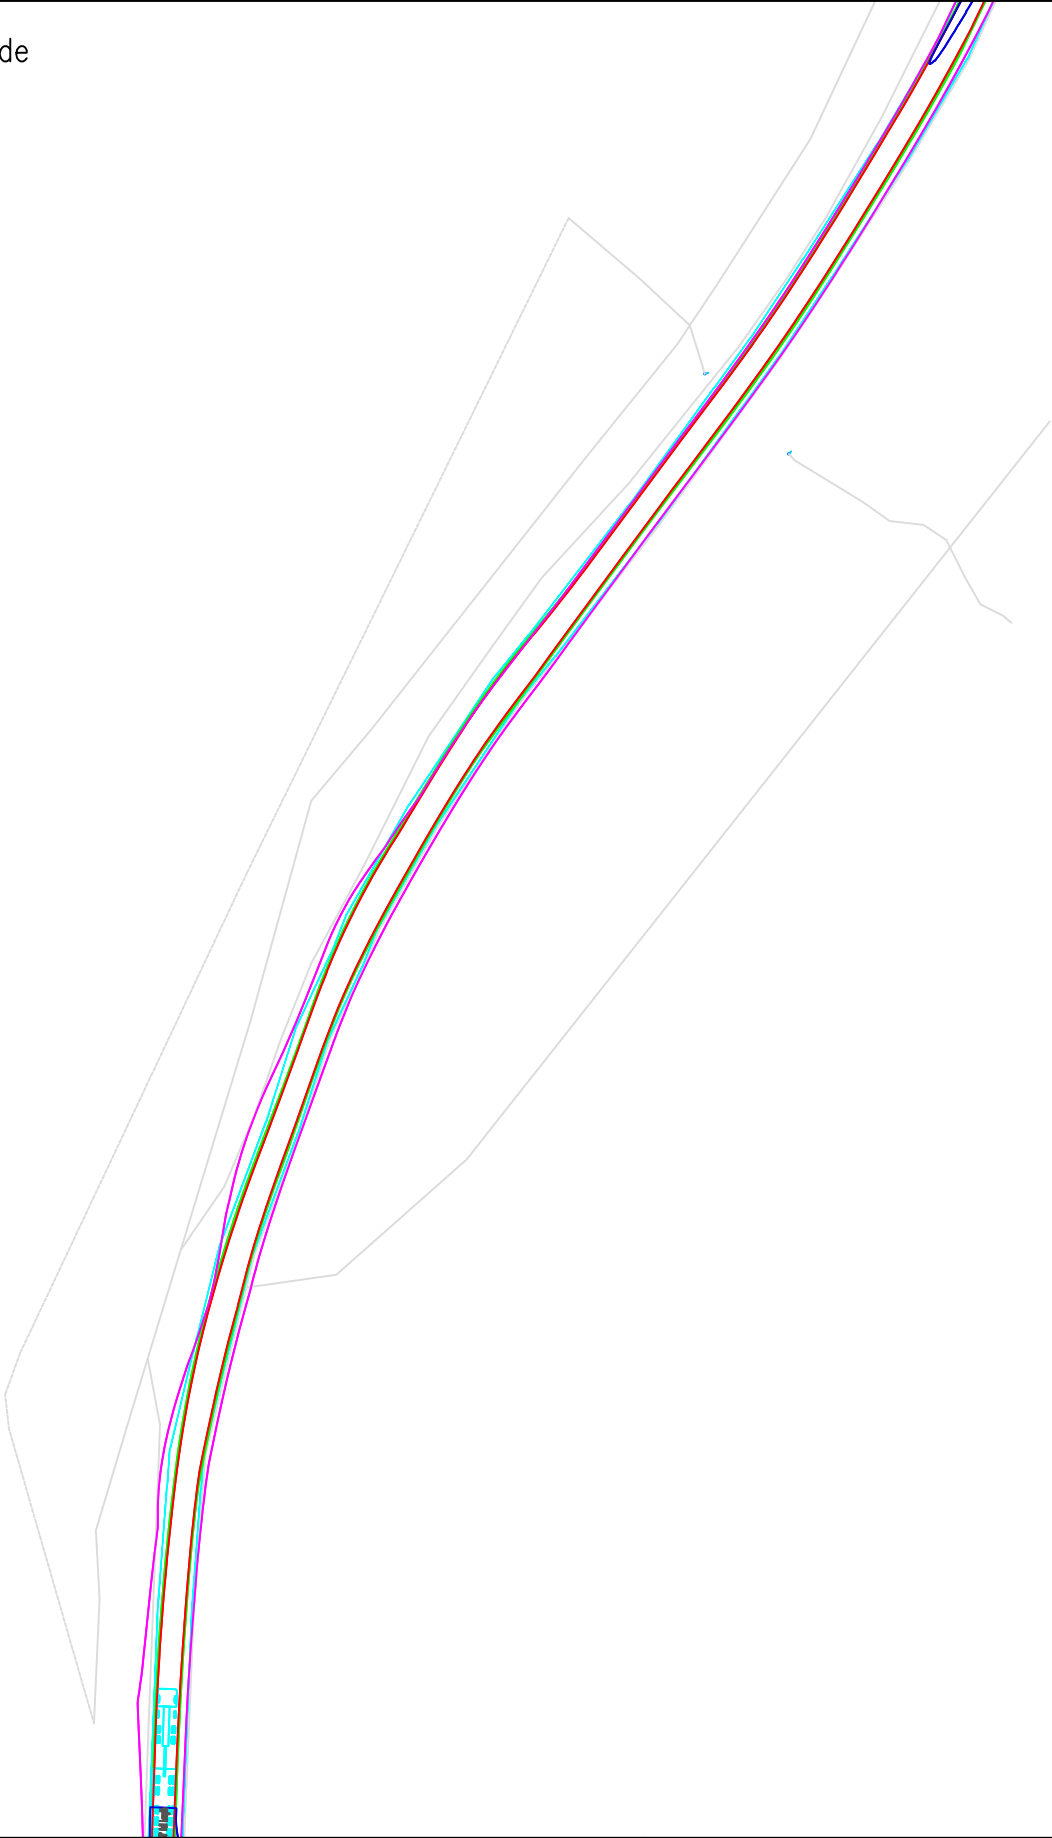


Tower

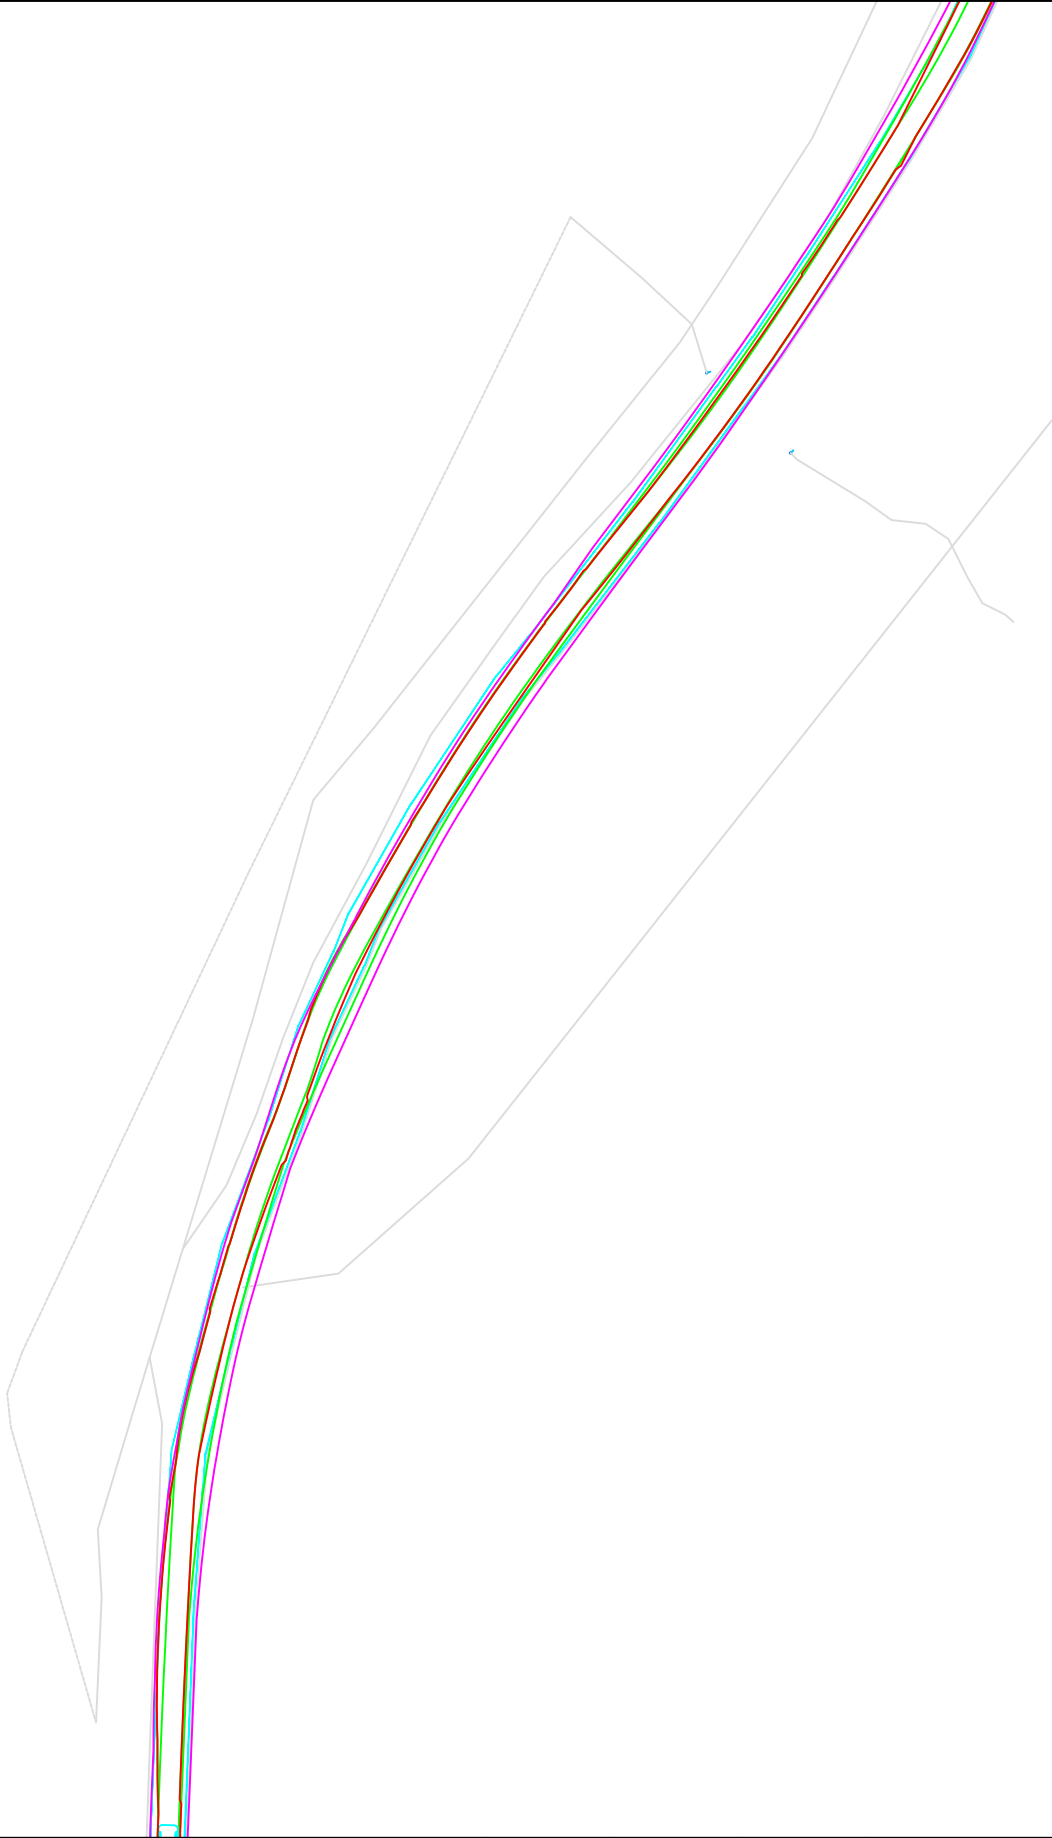

© Pell Frischmann

Pell Frischmann 93 GEORGE STREET, EDINBURGH, EH2 3ES Tel: +44 (0)131 240 1270 Email: pfeinburgh@pellfrischmann.com www.pellfrischmann.com	Project	Appin Wind Farm			Name	Date	Scale		1:1000 @ A3	
				Drawn	GLJ	15/07/2022	20620 - Appin Tracking [SG155 N163 SG170]_Part2			
				Designed	GLJ	15/07/2022	Final.dwg			
				Checked	GB	15/07/2022	Drawing Status			
Client	Statkraft	Drawing Title	SG155 / N163 / SG170 Blades & 29.977 x 4.8 x 4.793 Tower		Point of Interest		92		Draft	
					Drawing No.		Notes:		Revision	
Key	Wheel SPA Body SPA Load SPA Indicative Over-run Over-sail	SPA Location	Water of Ken Road Craigengillan Burn		SK57D		1. All mitigation is subject to confirmation through a test run. 2. This is not a construction drawing and is intended for illustration purposes only.		1	

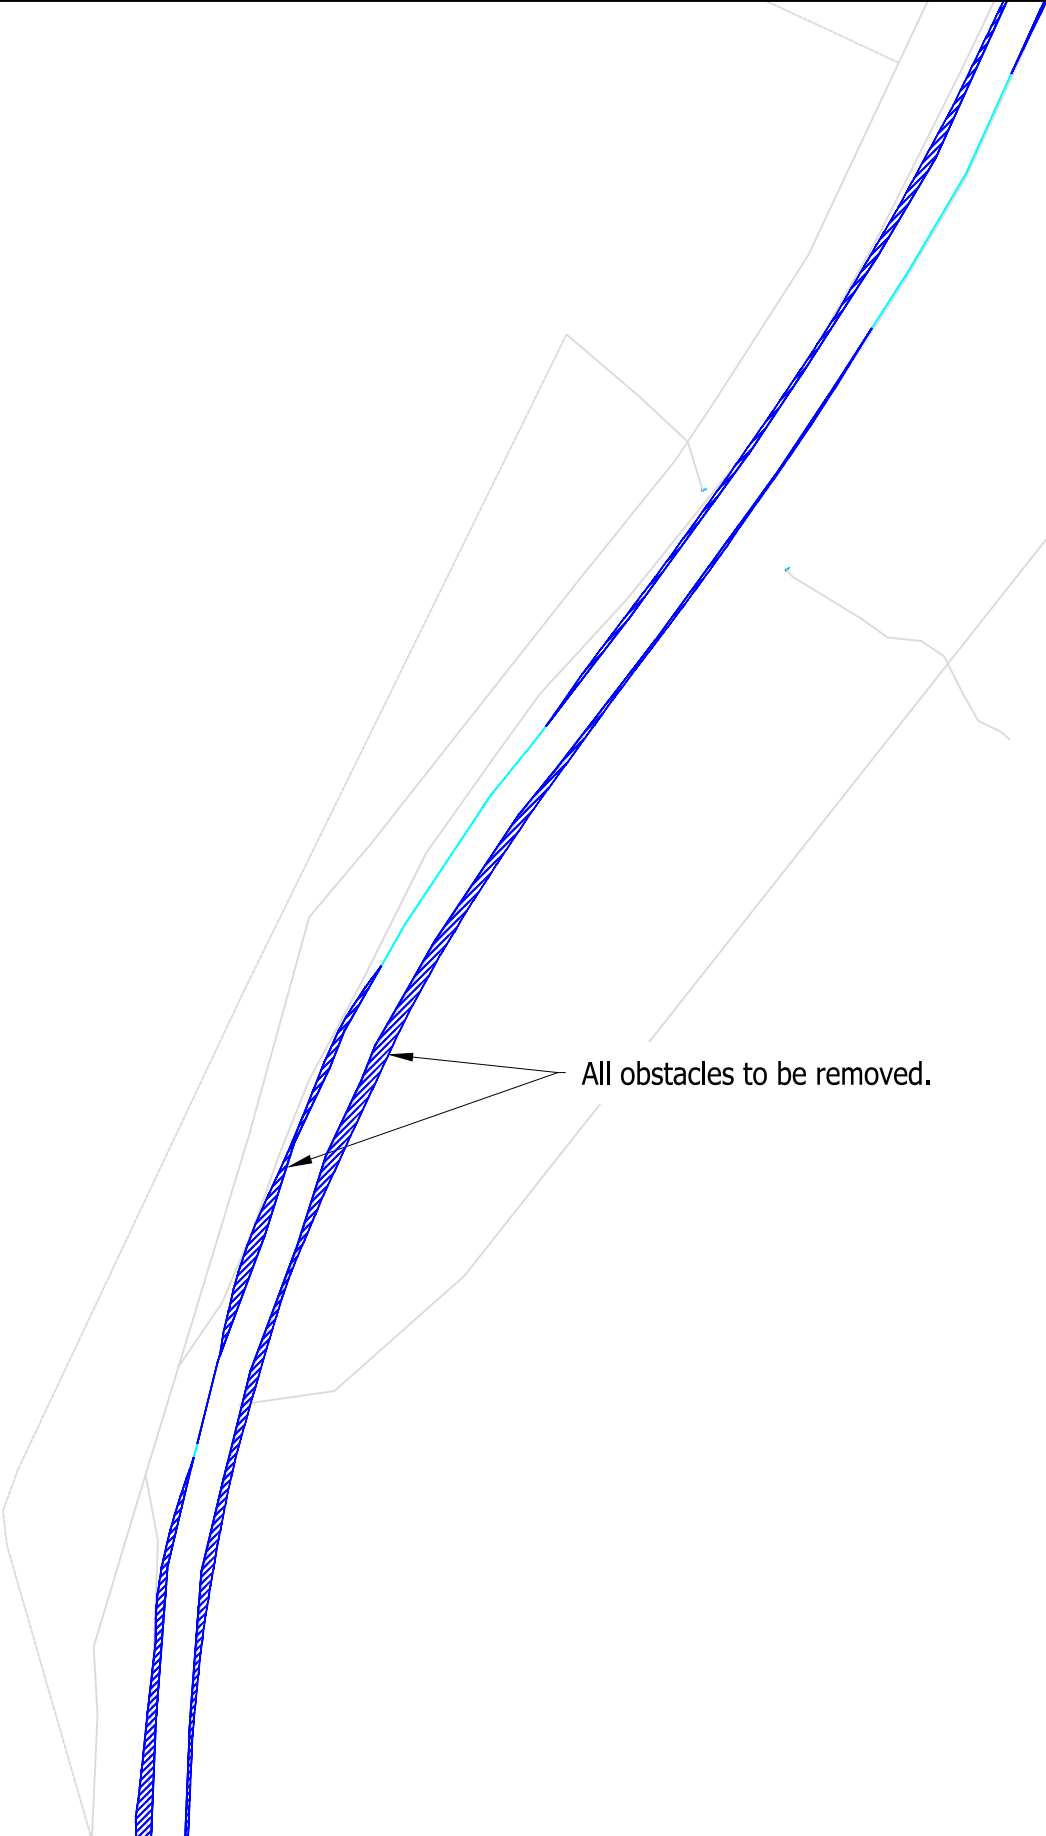


As built drawings have not been provided and as such indicative road edges have been provided however mitigation may have already been provided.


© Pell Frischmann

Pell Frischmann 93 GEORGE STREET, EDINBURGH, EH2 3ES Tel: +44 (0)131 240 1270 Email: p.fedinburgh@pellfrischmann.com www.pellfrischmann.com	Project			Name	Date	Scale	
	Appin Wind Farm		Drawn	GLJ	15/07/2022	1:1000 @ A3	
	Drawing Title		Designed	GLJ	15/07/2022	220622 - Appin Tracking [SG155 N163 SG170]_Part2	
			Checked	GB	15/07/2022	Final.dwg	
Client	Statkraft		Point of Interest		92	Drawing Status	
Key	SG155 / N163 / SG170 Blades & 29.977 x 4.8 x 4.793 Tower		Drawing No.		Notes:		Revision
	SPA Location		SK57E		1. All mitigation is subject to confirmation through a test run. 2. This is not a construction drawing and is intended for illustration purposes only.		1
	Wheel SPA	Body SPA	Load SPA	Indicative	Over-run	Over-sail	

SG155 Blade

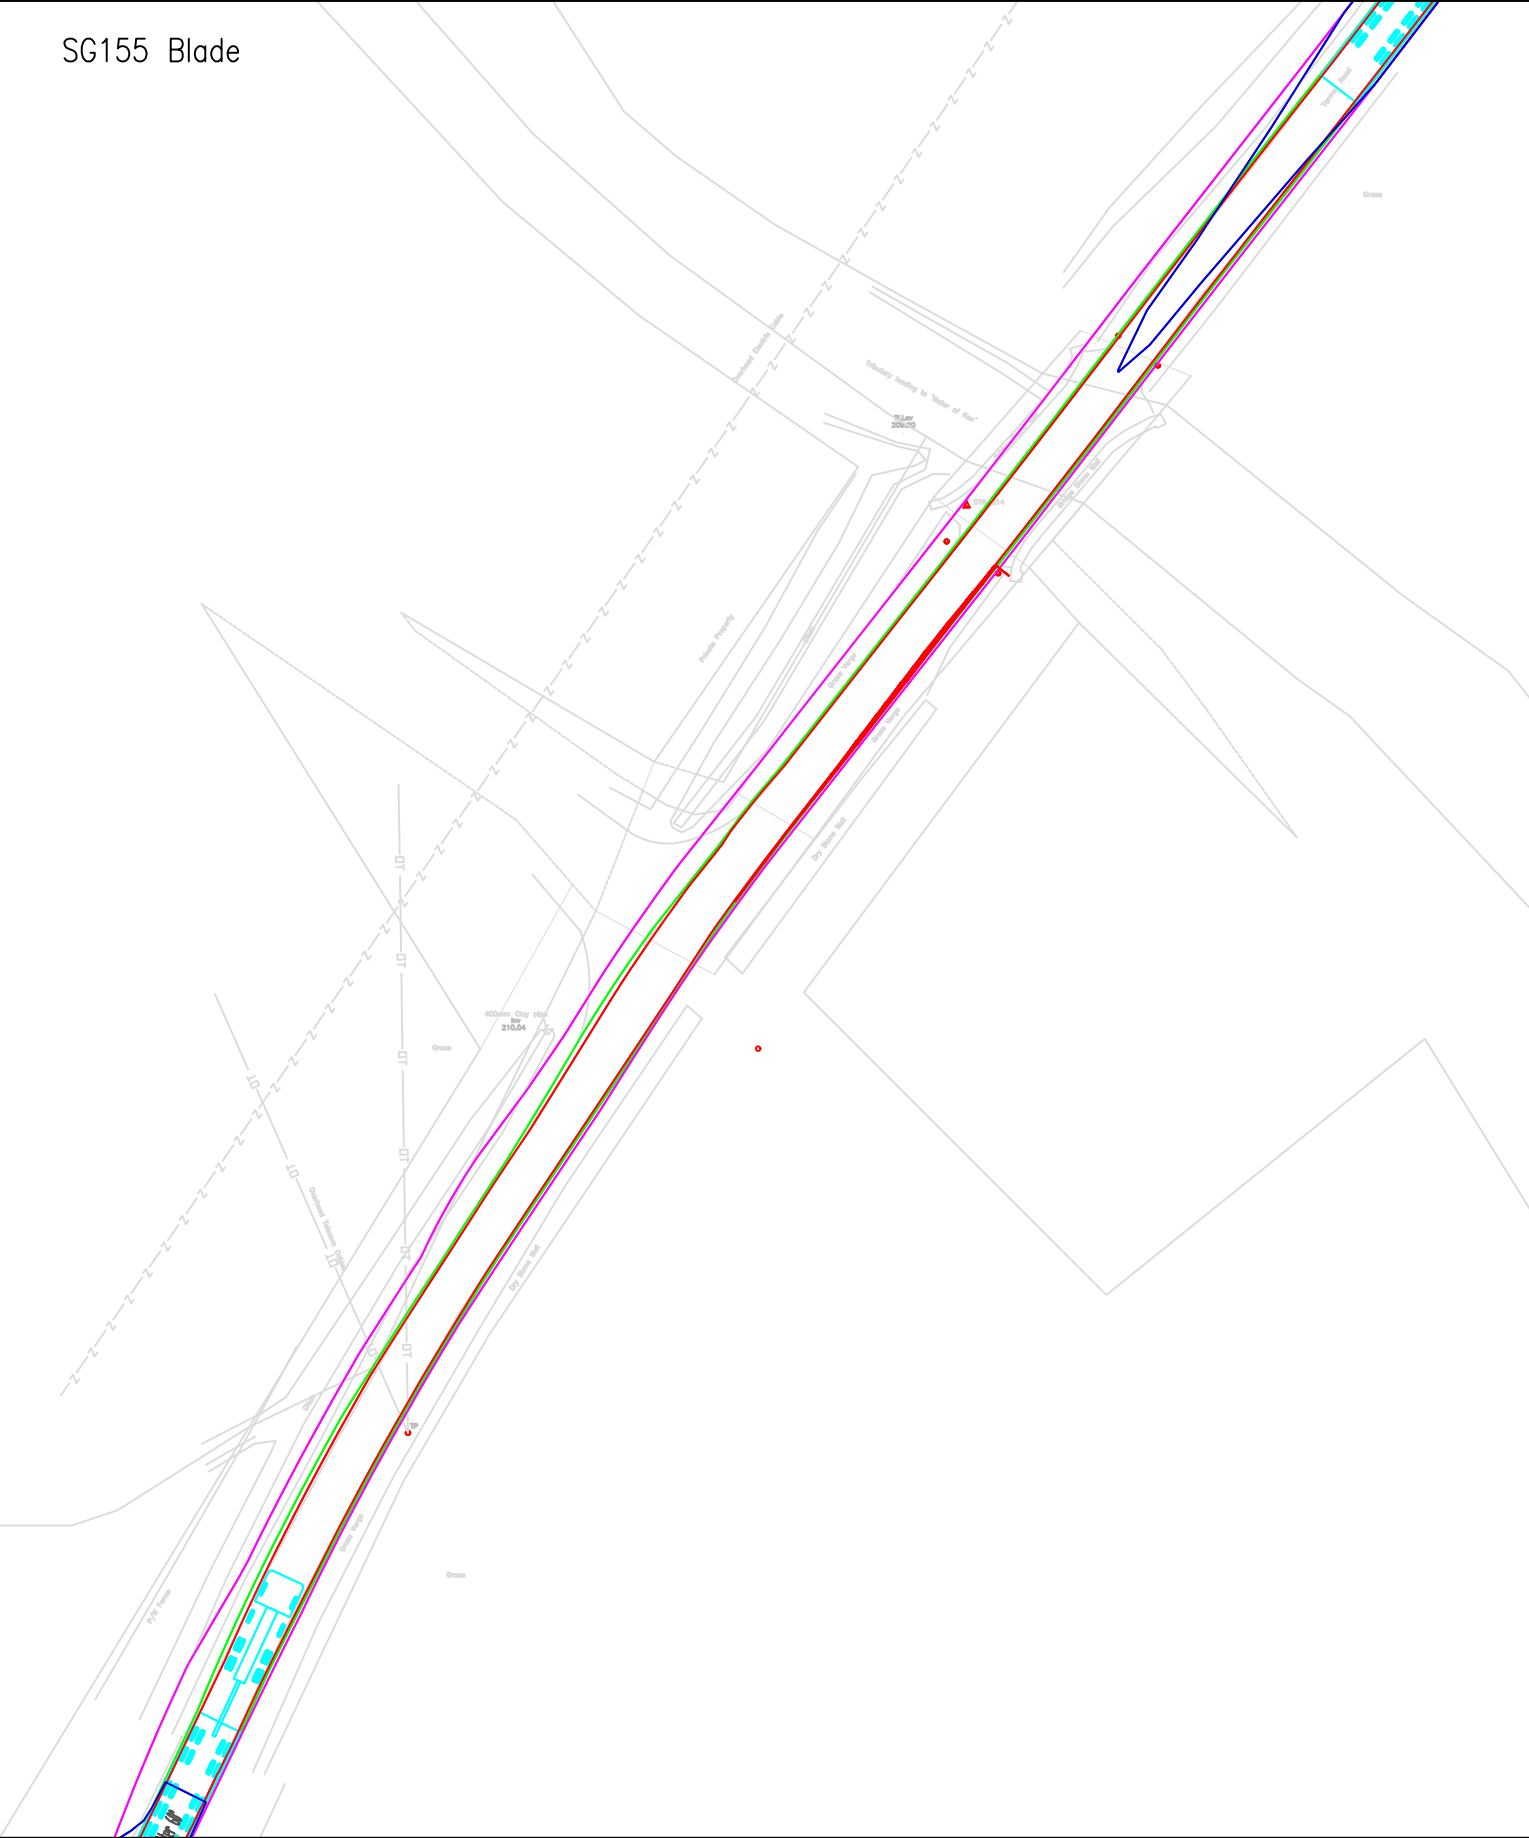

Tower

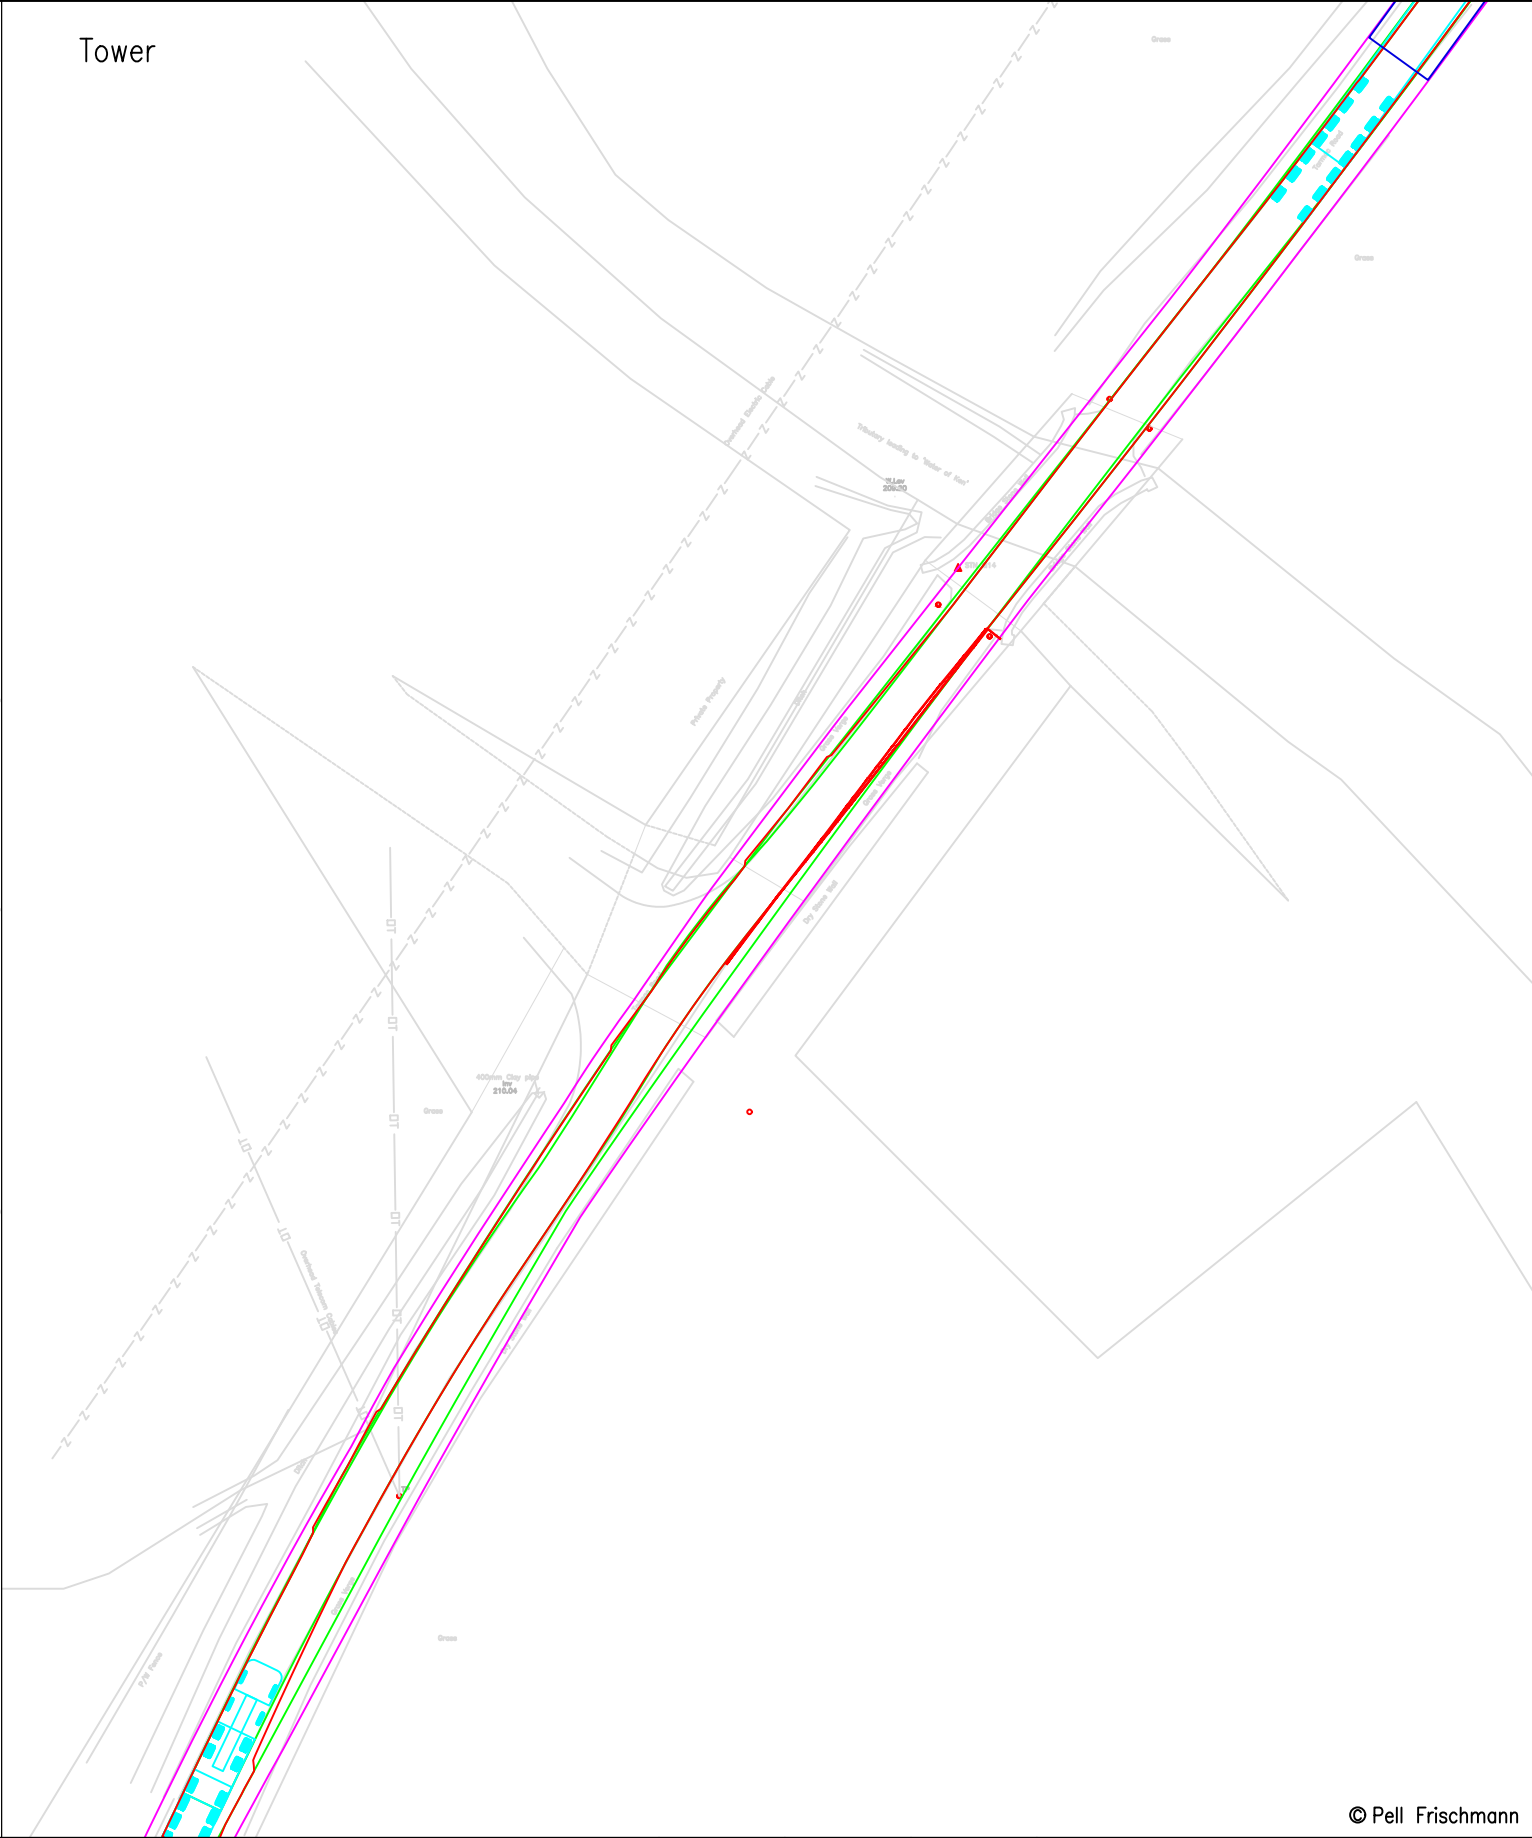

© Pell Frischmann

Pell Frischmann 93 GEORGE STREET, EDINBURGH, EH2 3ES Tel: +44 (0)131 240 1270 Email: pfedinburgh@pellfrischmann.com www.pellfrischmann.com		Project		Name		Date	Scale			
		Appin Wind Farm		Drawn		GLJ	15/07/2022	20620 - Appin Tracking [SG155 N163 SG170]_Part2 Final.dwg		
				Designed		GLJ	15/07/2022			
				Checked		GB	15/07/2022			
Client		Statkraft		Drawing Title		Point of Interest		93	Drawing Status	
Key Wheel SPA Body SPA Load SPA Indicative Over-run Over-sail		SPA Location		SG155 / N163 / SG170 Blades & 29.977 x 4.8 x 4.793 Tower		Drawing No.		Notes:		Revision
		Water of Ken Road Polifferie Burn				SK58		1. All mitigation is subject to confirmation through a test run. 2. This is not a construction drawing and is intended for illustration purposes only.		1

Key

Wheel SPA

Body SPA

Load SPA

Indicative

Over-run

Over-sail